

DRAWING SCHEDULE - ISSUE C

A 0000 TITLE PAGE	C
A 1000 BASIX CERTIFICATE	A
A 1201 LOWER BASEMENT	C
A 1202 UPPER BASEMENT	C
A 1203 FLOOD OVERFLOW	C
A 1204 GROUND FLOOR PLAN	C
A 1205 LEVEL 01	C
A 1206 LEVEL 02	C
A 1207 LEVEL 03	C
A 1208 LEVEL 04	C
A 1209 LEVEL 05	C
A 1210 LEVEL 06	C
A 1211 ROOF PLAN	C
A 1301 WEST ELEVATION	C
A 1302 SOUTH ELEVATION	C
A 1303 EAST ELEVATION	C
A 1304 NORTH ELEVATION	C
A1401 RAMP SECTION AA & BB	C
A 1402 SECTION CC	C
A 1403 SECTION DD	C
A 2001 GFA CALCULATION	C
A 2010 SOLAR ACCESS DIAGRAM	C
A 2020 CROSS-VENTILATION DIAGRAM	C
A 2021 FLOODING DESIGN- GROUND LEVEL	A
A 2022 FLOODING DESIGN- L01	A

FSR

SITE AREA: 1668 SQM
NO FSR CONTROL
GFA: 5101.78 (previously 5063.96 SQM)
TOTAL FSR: 3.06:1 (previously 3.04:1)

UNIT MIX

STUDIO: 7
1 BED: 7 (previously 4)
2 BED: 46 (previously 49)
3 BED: 4
UNITS TOTAL: 64

LANDSCAPE CALCULATION
(m²)

	APPROVED	PROPOSED
DEEP SOIL	226.15	215.09
LANDSCAPING	373.72	327.44
COS	345.02	352.44

LANDSCAPING AND
COMMON OPEN SPACE UPDATED

REV.

AMENDMENT SCHEDULE for 125-129 Arthur St, Parramatta - S4.55

This schedule is to indicate all the amendments between current issue and the approved plans.

Amendments are to satisfy flood safety requirements, and address minor changes for CC, due to structure or services
All newly reconfigured units are complied with ADG requirements; room size in meter are noted on the plans. No change to the approved façade material.

Drawing A1201 LOWER BASEMENT PLAN

Re-calculated required parking, based on updated Unit Mix. Remains compliant with ADG.
- Size of service room allocated and adjusted.
- Relocated 2 (two) accessible parking spaces and associated shared space from Upper Basement level.

Drawing A1202 UPPER BASEMENT PLAN

- Sprinkler water tank included under approved ramp.

Drawing A1203 FLOOD OVERFLOW LEVEL

- Size of OSD adjusted as per stormwater consultant advisement.
- Indicated substation(base)

Drawing A1204 GROUND FLOOR PLAN

- Connected north & south building corridor as per flood engineer comments for flooding safety purpose.
- Unit G05 & G06, updated unit layout, G05 down size from 2Bed to 1Bed unit
- Added one internal communal stair to connect to level 02 as per flood engineer comments
- Indicated one substation as per CC requested.
- Pergola removed for fire safety

Drawing A1205 LEVEL 01

- Inclusion of refugee area in between units 105 and 106, with accessible toilet, bench and first aid
- Raised building from L01 by 300mm to reach RL9.3 for flood safety purpose
- Unit 105 & 106, updated layout, both units downsized from two (2) bedroom to one (1) bedroom unit
- Unit 102, relocated one bedroom window to be away from substation below

Drawing A1210 LEVEL 06

- Unit 601
-Updated layout, swap bedroom with living area, with living area to face east for better solar access
- Common WC removed
- Pergola removed for fire safety

ELEVATIONS & SECTIONS

- Height of ground floor raised in order to have L01 at RL 9.3 due to flooding issue
- Updated accordingly as per plan amendments
- Sliding door heights reduced 100mm, from 2700mm to 2600mm to allow ceiling heights

GFA CALCULATION

- GFA changed slightly due to internal changes
- New calculated GFA 5101.78sqm (previously approved as 5063.96sqm)

SOLAR ACCESS & CROSS-VENTILATION

- Calculations changes slightly due to internal changes

LANDSCAPE CALCULATION



- Landscape and common open space calculations updated

T. +612 9744 7035 | E. office@ghazia.com
ACN: 67167131848
LEVEL 2, OFFICE 2
14 RAILWAY PARADE
BURWOOD, NSW 2134




GHAZI AL ALI
ARCHITECT
PTY LTD
NSW reg. no. 7542


125-129 ARTHUR STREET
PARRAMATTA

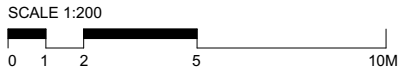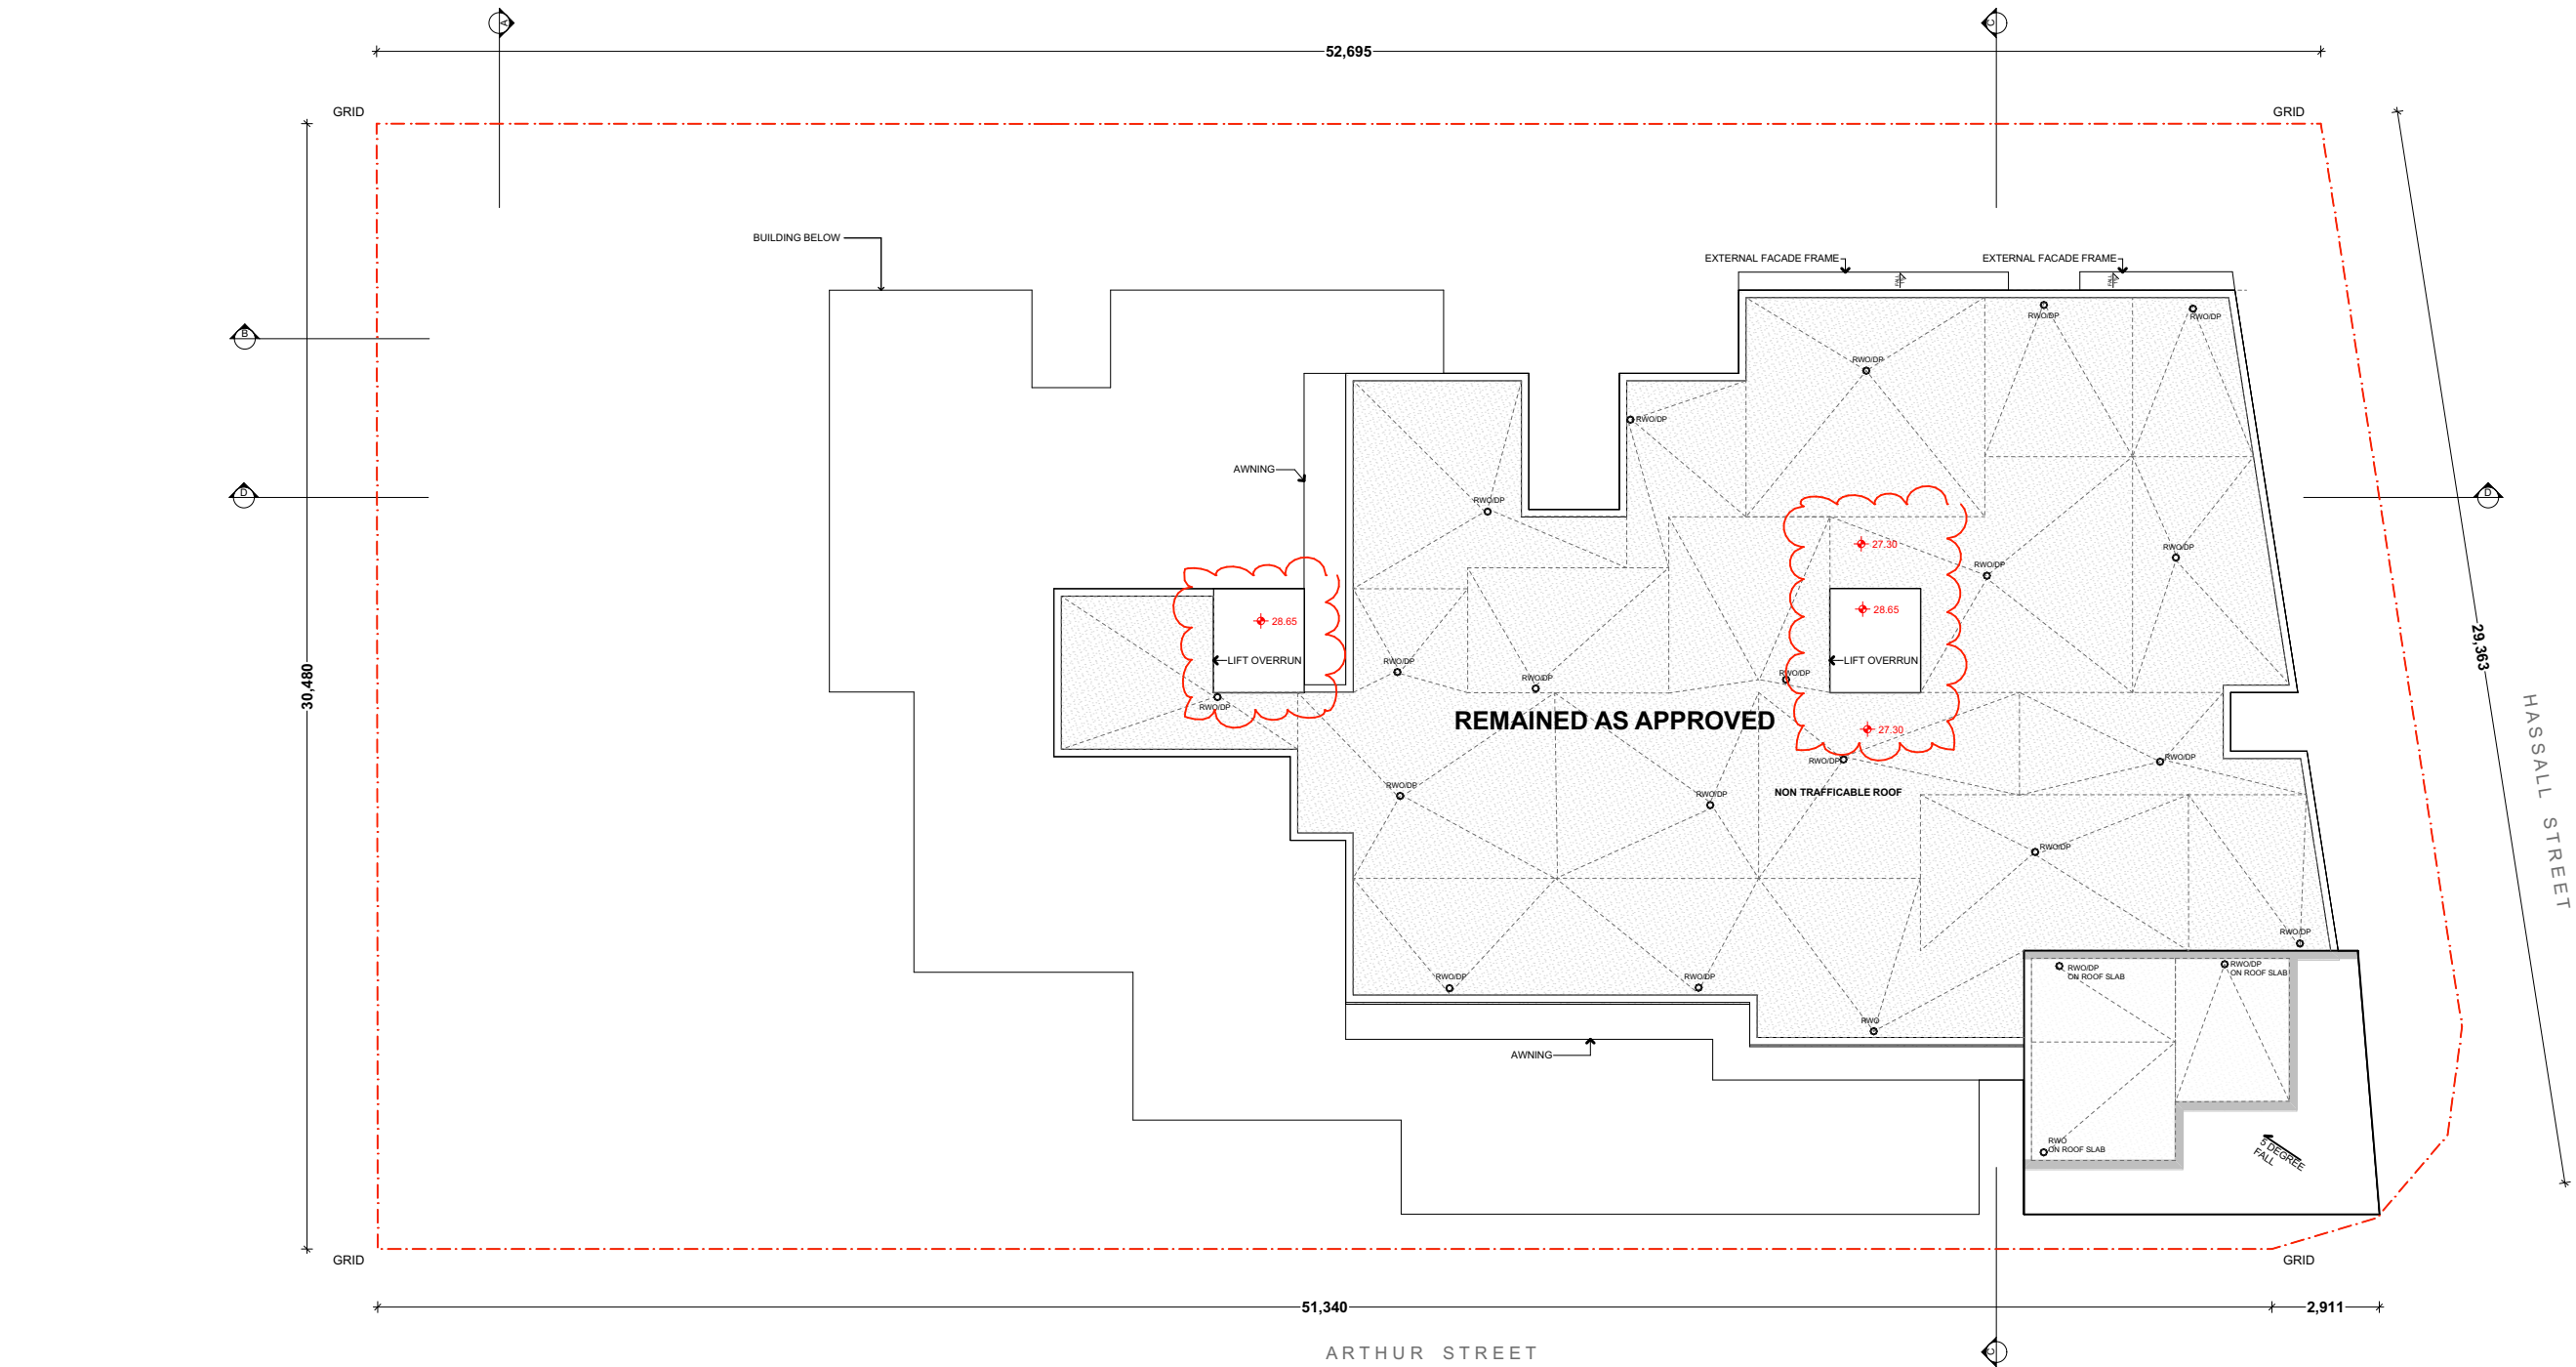

FOR DA PURPOSES ONLY NOT FOR CONSTRUCTION DA		A3 Drawing Original Size	<table><tr><td>C</td><td>27/10/2021</td><td>S4.95</td><td>SECTION 96</td></tr><tr><td>B</td><td>30/09/2018</td><td>2018</td><td>SECTION 96</td></tr><tr><td>A</td><td>30/09/2018</td><td>2018</td><td>SECTION 96</td></tr></table>	C	27/10/2021	S4.95	SECTION 96	B	30/09/2018	2018	SECTION 96	A	30/09/2018	2018	SECTION 96	<p>© COPYRIGHT</p> <p>DO NOT SCALE DWGS. USE DIMENSIONS ONLY. REFER ANY DISCREPANCIES TO ARCHITECT PRIOR TO CONSTRUCTION.</p> <p>THESE DRAWINGS ARE SUBJECT TO COPYRIGHT.</p>		<p>BCA/ ACCESS:</p> <p>BUILDING INNOVATIONS AUSTRALIA 2/28-30/34-36 Regent Street, SURRY HILLS NSW 2150 T: (02) 8014 7700 F: (02) 8014 7701 E: bca@buildinginnovations.net.au</p> <p>ACOUSTIC:</p> <p>ACOUSTIC LOGIC A: 9 Barrah St, Mascot NSW 2020 PO Box 208, Mascot NSW 2020 T: (02) 8339 8000 / F: (02) 8338 8399</p> <p>STORMWATER:</p> <p>SGC 11/11 Regent St, Level 1, 20/21 Regent St, Surry Hills NSW 2150 T: (02) 8014 7700 F: (02) 8014 7701 E: bca@buildinginnovations.net.au</p> <p>LANDSCAPING:</p> <p>CONCEPT LANDSCAPE ARCHITECTS 11/11 Regent St, Level 1, 20/21 Regent St, Surry Hills NSW 2150 T: (02) 8014 7700 F: (02) 8014 7701 E: bca@buildinginnovations.net.au</p> <p>PLANNING:</p> <p>415 URBAN PLANNING SOLUTIONS PO Box 208, 208 Regent St, Surry Hills NSW 2150 T: (02) 8014 7700 F: (02) 8014 7701 E: bca@buildinginnovations.net.au</p> <p>SURVEY:</p> <p>SDC 11/11 Regent St, Level 1, 20/21 Regent St, Surry Hills NSW 2150 T: (02) 8014 7700 F: (02) 8014 7701 E: bca@buildinginnovations.net.au</p> <p>SUBSTATION:</p> <p>AAPOWER ENGINEERING Commercial 2/28 - 32 Marsh St, Woll Creek 2205 T: (02) 9576 45122 E: aapower@aaengineering.com</p> <p>BASIX:</p> <p>OUTSOURCE IDEAS PTY LTD 11/11 Regent St, Level 1, 20/21 Regent St, Surry Hills NSW 2150 T: (02) 8014 7700 F: (02) 8014 7701 E: bca@buildinginnovations.net.au</p>	<p>ARCHITECT:</p> <p>GHAZI AL ALI ARCHITECT PTY LTD T: +612 9744 7035 E: office@ghazia.com ACN: 67167131848 LEVEL 2, OFFICE 2, 14 RAILWAY PARADE, BURWOOD, NSW 2134</p>	<p>PROJECT:</p> <p>125-129 ARTHUR ST, PARRAMATTA</p> <p>CLIENT:</p> <p>ANTHILL CONSTRUCTION PTY LTD</p> <p>SCALE:</p> <p>1:200</p> <p>DATE:</p> <p>27/10/2021</p> <p>CAD FILE NUMBER:</p> <p>DRAWN BY:</p> <p>SN</p> <p>CHECKED 1:</p> <p>LL</p> <p>CHECKED 2:</p> <p>GA</p> <p>APPROVED:</p> <p>GA</p>	<p>DRAWING NAME</p> <p>ROOF PLAN</p> <p>DRAWING NUMBER</p> <p>DA</p> <p>PROJECT NUMBER</p> <p>92.15</p> <p>ISSUE</p> <p>C</p>
C	27/10/2021	S4.95	SECTION 96																		
B	30/09/2018	2018	SECTION 96																		
A	30/09/2018	2018	SECTION 96																		

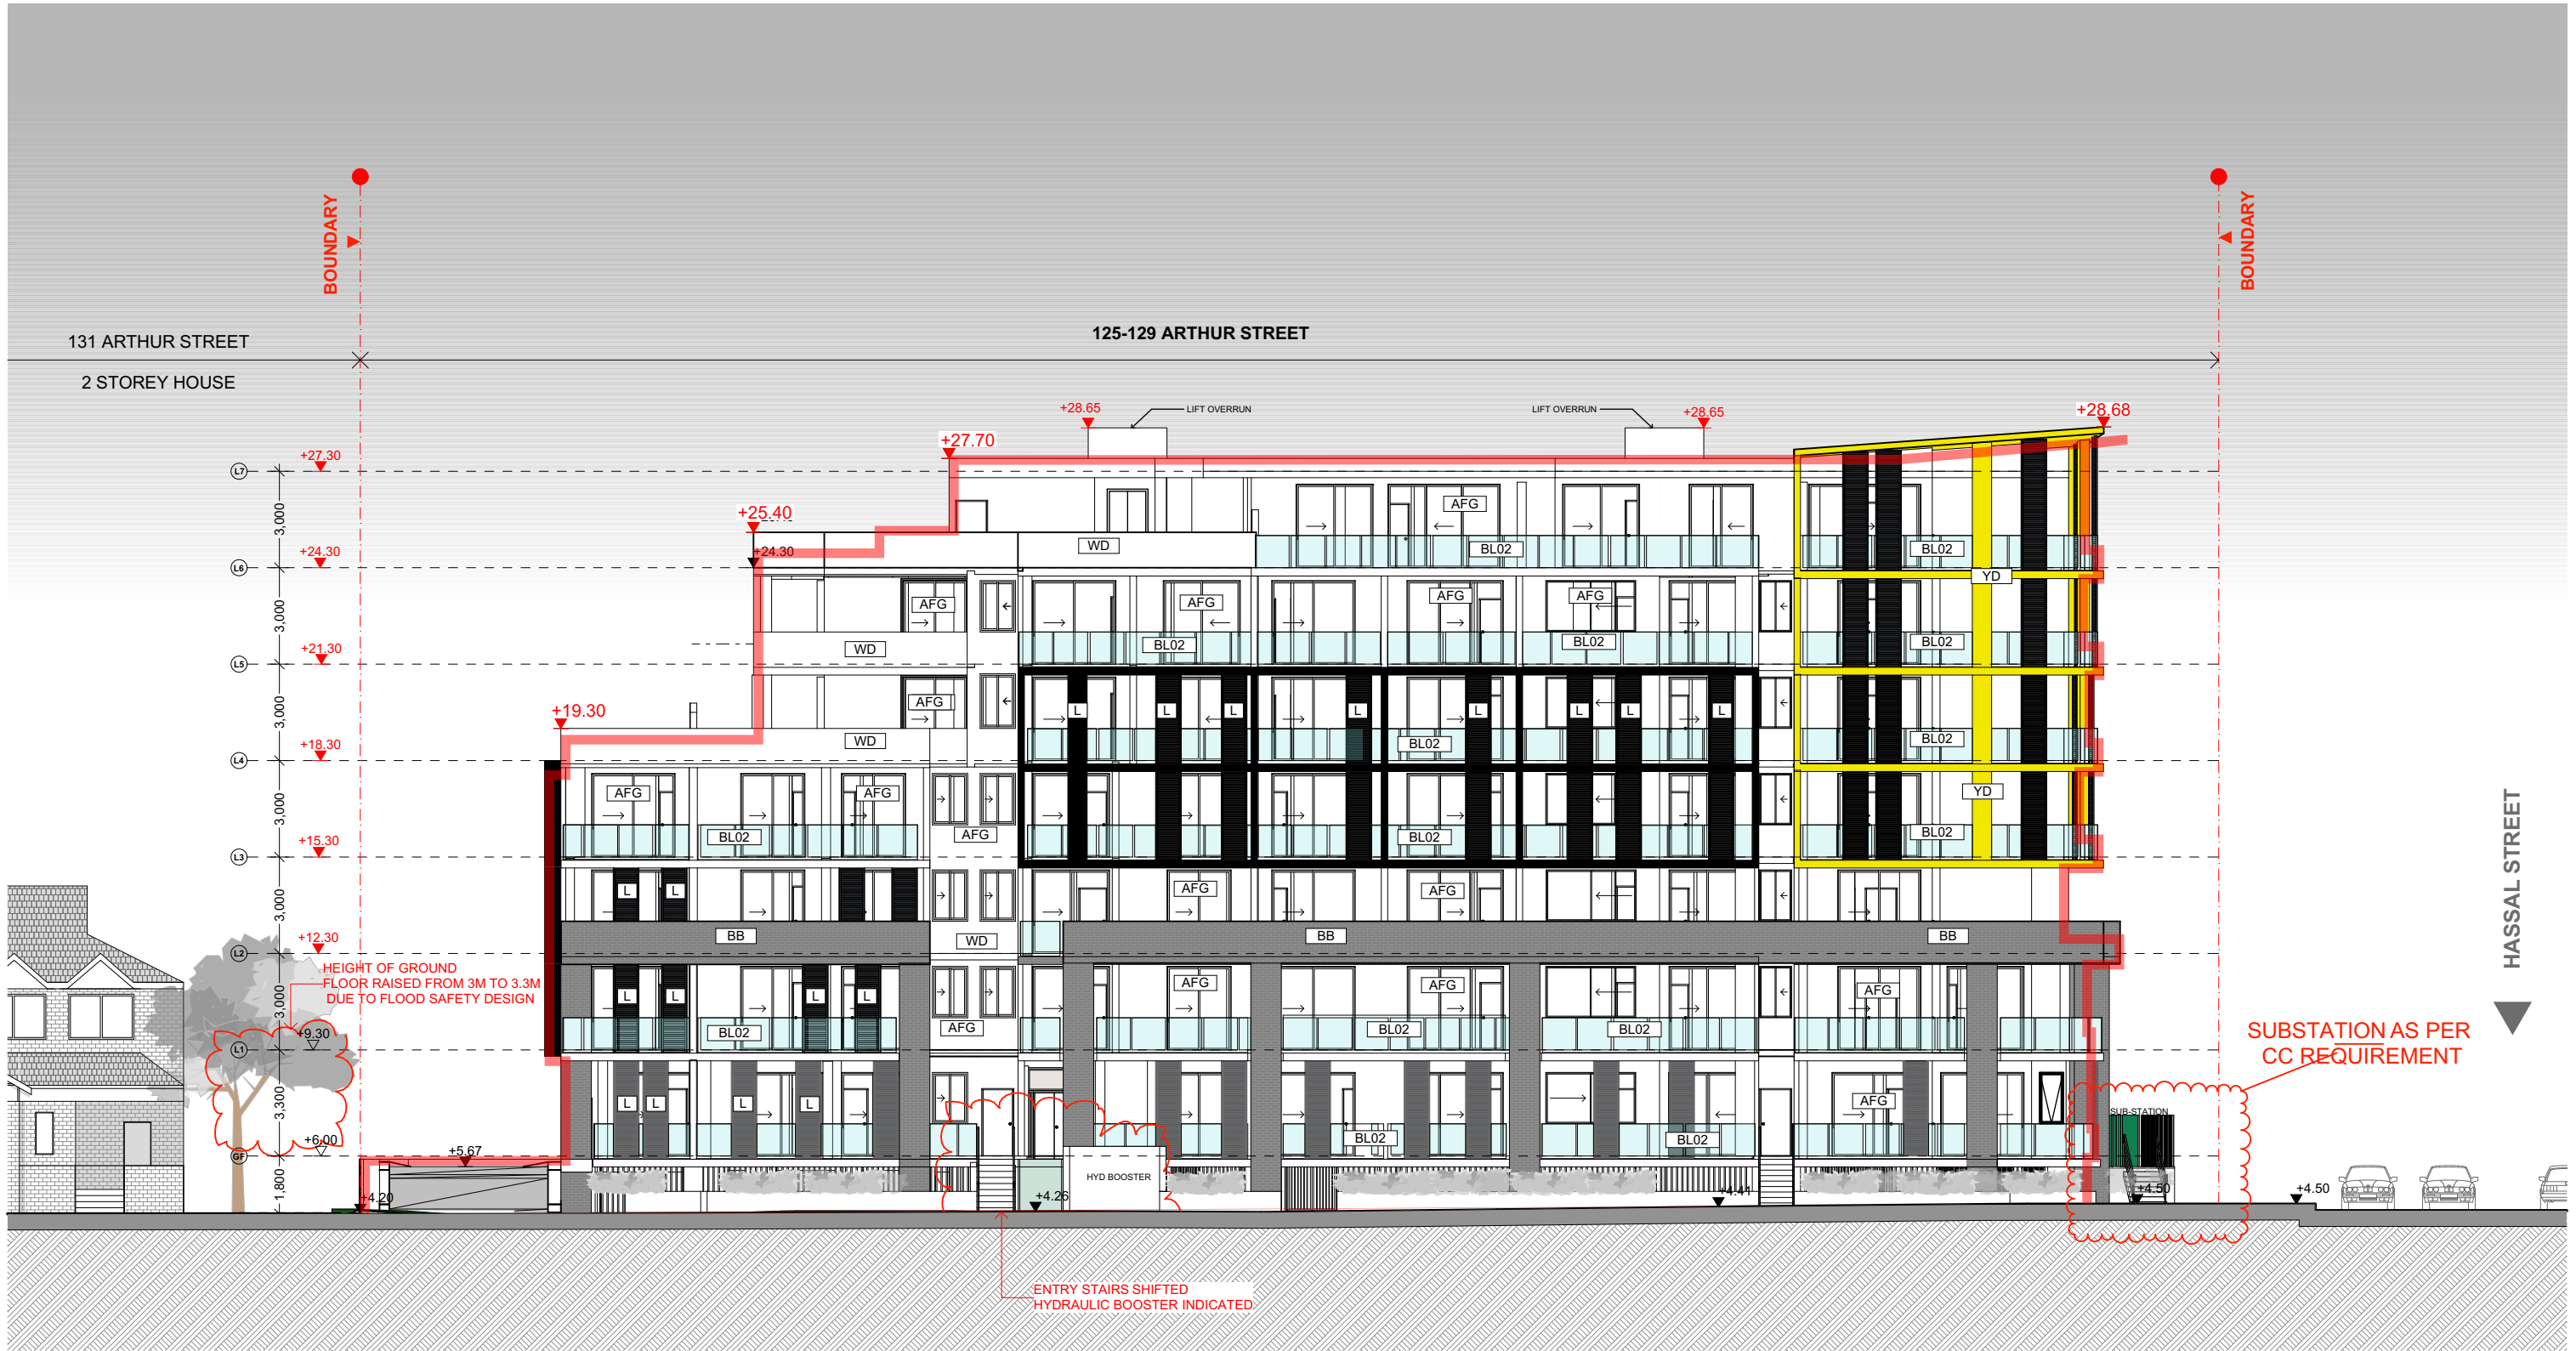

FINISHES LEGEND	
WALLS AND CLADDING	GLAZING / GLAZED SCREENS
BB FACE BRICK	AFG ALUMINIUM FRAMED GLAZING
GD PAINT FINISH TYPE 2 DULUX RAKU or SIMILAR	BL02 GLASS BALUSTRADE
YD PAINT FINISH TYPE 2 DULUX RAPUNZEL	
WD WHITE RENDER(DULUX B 12 VIVID WHITE)	
L ALUMINIUM GREY LOUVER	

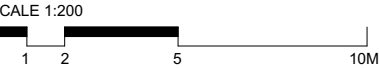

FOR DA PURPOSES ONLY
NOT FOR CONSTRUCTION
DA

Drawing Original Size
A3

C	27/10/2021	S4.95	SECTION 96
B	20/10/2021		SECTION 96
A	30/09/2021		SECTION 96

Issue	Date	Description
1	27/10/2021	Issue for DA

© COPYRIGHT

DO NOT SCALE DWGS. USE DIMENSIONS ONLY. REFER ANY DISCREPANCIES TO ARCHITECT PRIOR TO CONSTRUCTION.

THESE DRAWINGS ARE SUBJECT TO COPYRIGHT.

BCA/ ACCESS:

BUILDING INNOVATIONS AUSTRALIA
20th St, 5th Fl, 20th St, Sydney NSW 2010
T: (02) 8014 7700 F: (02) 8014 7701
E: bina@buildinginnovations.net.au

ACOUSTIC:

ACOUSTIC LOGIC
A: 9 Barren St, Mascot NSW 2020 PO Box 208
Mascot NSW 2020
T: (02) 8339 8000 F: (02) 8338 8399
E: info@acousticlogic.net.au

STORMWATER:

Sgc
415 URBAN PLANNING SOLUTIONS
PO Box 218, Burwood NSW 2133
T: (02) 9576 4512 F: (02) 9576 4513
E: info@sgc.net.au

LANDSCAPING:

CONCEPT LANDSCAPE ARCHITECTS
100/102, 100/102 St, Cammeray NSW 2050
T: (02) 9551 5112 F: (02) 9551 5111
E: info@concept.net.au

PLANNING:

415 URBAN PLANNING SOLUTIONS
PO Box 218, Burwood NSW 2133
T: (02) 9576 4512 F: (02) 9576 4513
E: info@sgc.net.au

SURVEY

SDC
100/102 St, Cammeray NSW 2050
T: (02) 9551 5112 F: (02) 9551 5111
E: info@concept.net.au

SUBSTATION:

AAPOWER ENGINEERING
Commercial 2/26 - 32 Marsh St, Woll Creek
2205
T: (02) 9576 4512 F: (02) 9576 4513
E: info@sgc.net.au

BASIX

SDC
100/102 St, Cammeray NSW 2050
T: (02) 9551 5112 F: (02) 9551 5111
E: info@concept.net.au

ARCHITECT:

GHAZI AL ALI ARCHITECT PTY LTD
T: +612 9744 7035 | E: office@ghazia.com
ACN: 67167131848
LEVEL 2, OFFICE 2
14 RAILWAY PARADE, BURWOOD, NSW 2134

PROJECT:

125-129 ARTHUR ST, PARRAMATTA

CLIENT:

ANTHILL CONSTRUCTION PTY LTD

SCALE:

1:200

DATE:

27/10/2021

CAD FILE NUMBER:

GA

DRAWN BY:

SN

CHECKED 1:

LL

CHECKED 2:

GA

APPROVED:

GA

DRAWING NAME

WEST ELEVATION

DRAWING NUMBER


DA

PROJECT NUMBER


92.15

ISSUE

C

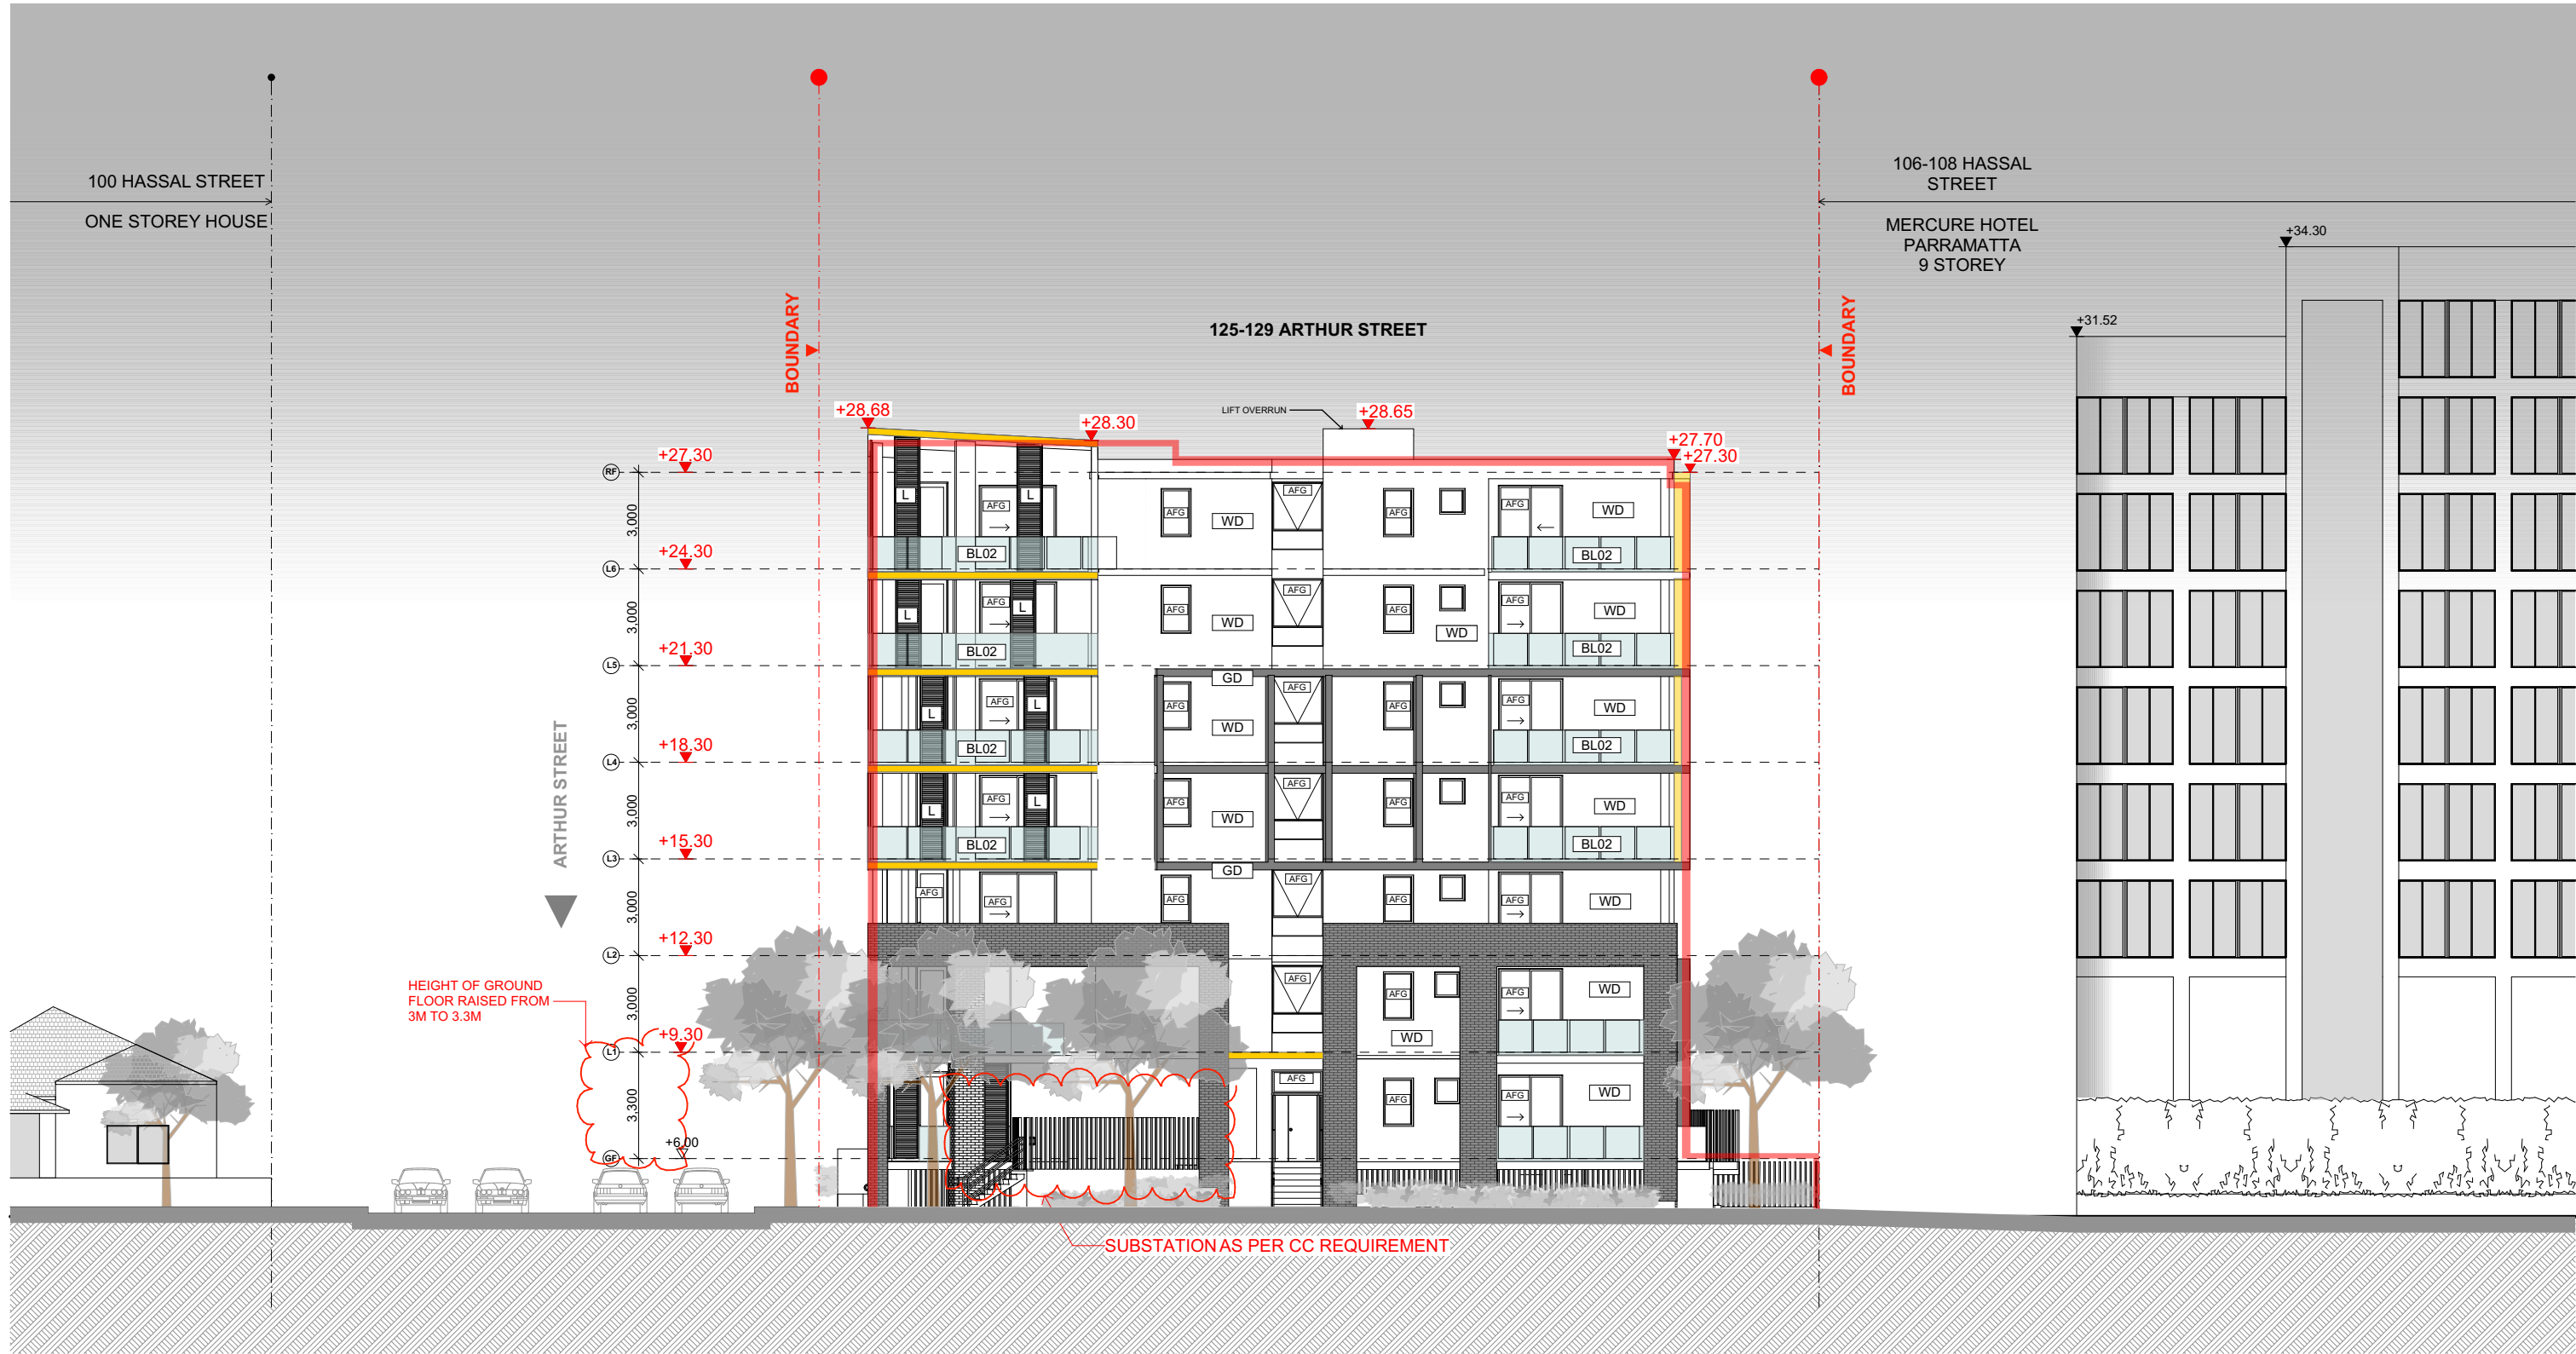

FINISHES LEGEND	
WALLS AND CLADDING	GLAZING / GLAZED SCREENS
BB FACE BRICK	AFG ALUMINIUM FRAMED GLAZING
GD PAINT FINISH TYPE 2 DULUX RAKU or SIMILAR	BL02 GLASS BALUSTRADE
YD PAINT FINISH TYPE 2 DULUX RAPUNZEL	
WD WHITE RENDER(DULUX B 12 VIVID WHITE)	
L ALUMINIUM GREY LOUVER	

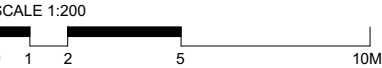

FOR DA PURPOSES ONLY
NOT FOR CONSTRUCTION

DA

Drawing Original Size

A3

C	27/10/2021	S4.95	SECTION 96
B	30/09/2018		SECTION 96
A	30/09/2018		SECTION 96

Issue	Date	Description
1	27/10/2021	Issue for DA

© COPYRIGHT

DO NOT SCALE DWGS. USE DIMENSIONS ONLY. REFER ANY DISCREPANCIES TO ARCHITECT PRIOR TO CONSTRUCTION.

THESE DRAWINGS ARE SUBJECT TO COPYRIGHT.

BCA/ ACCESS:

BUILDING INNOVATIONS AUSTRALIA
20th St, 5th Fl, 20th St, Sydney NSW 2010
T: (02) 8014 7700 F: (02) 8014 7701
E: bca@buildinginnovations.com.au

ACOUSTIC:

ACOUSTIC LOGIC
A: 9 Barren St, Mascot NSW 2020 PO Box 208, Mascot NSW 2020
T: (02) 8339 8000 F: (02) 8338 8399
E: info@acousticlogic.com.au

STORMWATER:

Sg
415 URBAN PLANNING SOLUTIONS
PO Box 208, Mascot NSW 2020
T: (02) 9576 45122 F: (02) 9576 45122
E: info@sg.com.au

LANDSCAPING:

CONCEPT LANDSCAPE ARCHITECTS
100/102, 100/102 St, Cammeray NSW 2050
T: (02) 9552 5122 F: (02) 9552 5122
E: info@conceptlandscape.com.au

PLANNING:

415 URBAN PLANNING SOLUTIONS
PO Box 208, Mascot NSW 2020
T: (02) 9576 45122 F: (02) 9576 45122
E: info@sg.com.au

SURVEY:

SDC
100/102 St, Cammeray NSW 2050
T: (02) 9552 5122 F: (02) 9552 5122
E: info@conceptlandscape.com.au

SUBSTATION:

AAPOWER ENGINEERING
Commercial 2/26 - 32 Marsh St, Woll Creek NSW 2205
T: (02) 9576 45122 F: (02) 9576 45122
E: info@sg.com.au

BASIX:

OUTSOURCE IDEAS
PTY LTD
Suite 202, Level 3, 33 Leighton St
North Sydney NSW 2060
T: (02) 9552 5122 F: (02) 9552 5122
E: info@conceptlandscape.com.au

ARCHITECT:

GHAZI AL ALI ARCHITECT PTY LTD
T: +612 9744 7035 | E: office@ghazia.com
ACN: 67167131848
LEVEL 2, OFFICE 2, 14 RAILWAY PARADE, BURWOOD, NSW 2134

PROJECT:

125-129 ARTHUR ST, PARRAMATTA

CLIENT:

ANTHILL CONSTRUCTION PTY LTD

SCALE:

1:200

DRAWN BY:

SN

CHECKED 1:

LL

CHECKED 2:

GA

APPROVED:

GA

CAD FILE NUMBER:

DRAWING NAME:

SOUTH ELEVATION

DRAWING NUMBER:


DA

PROJECT NUMBER:


92.15

ISSUE:

C

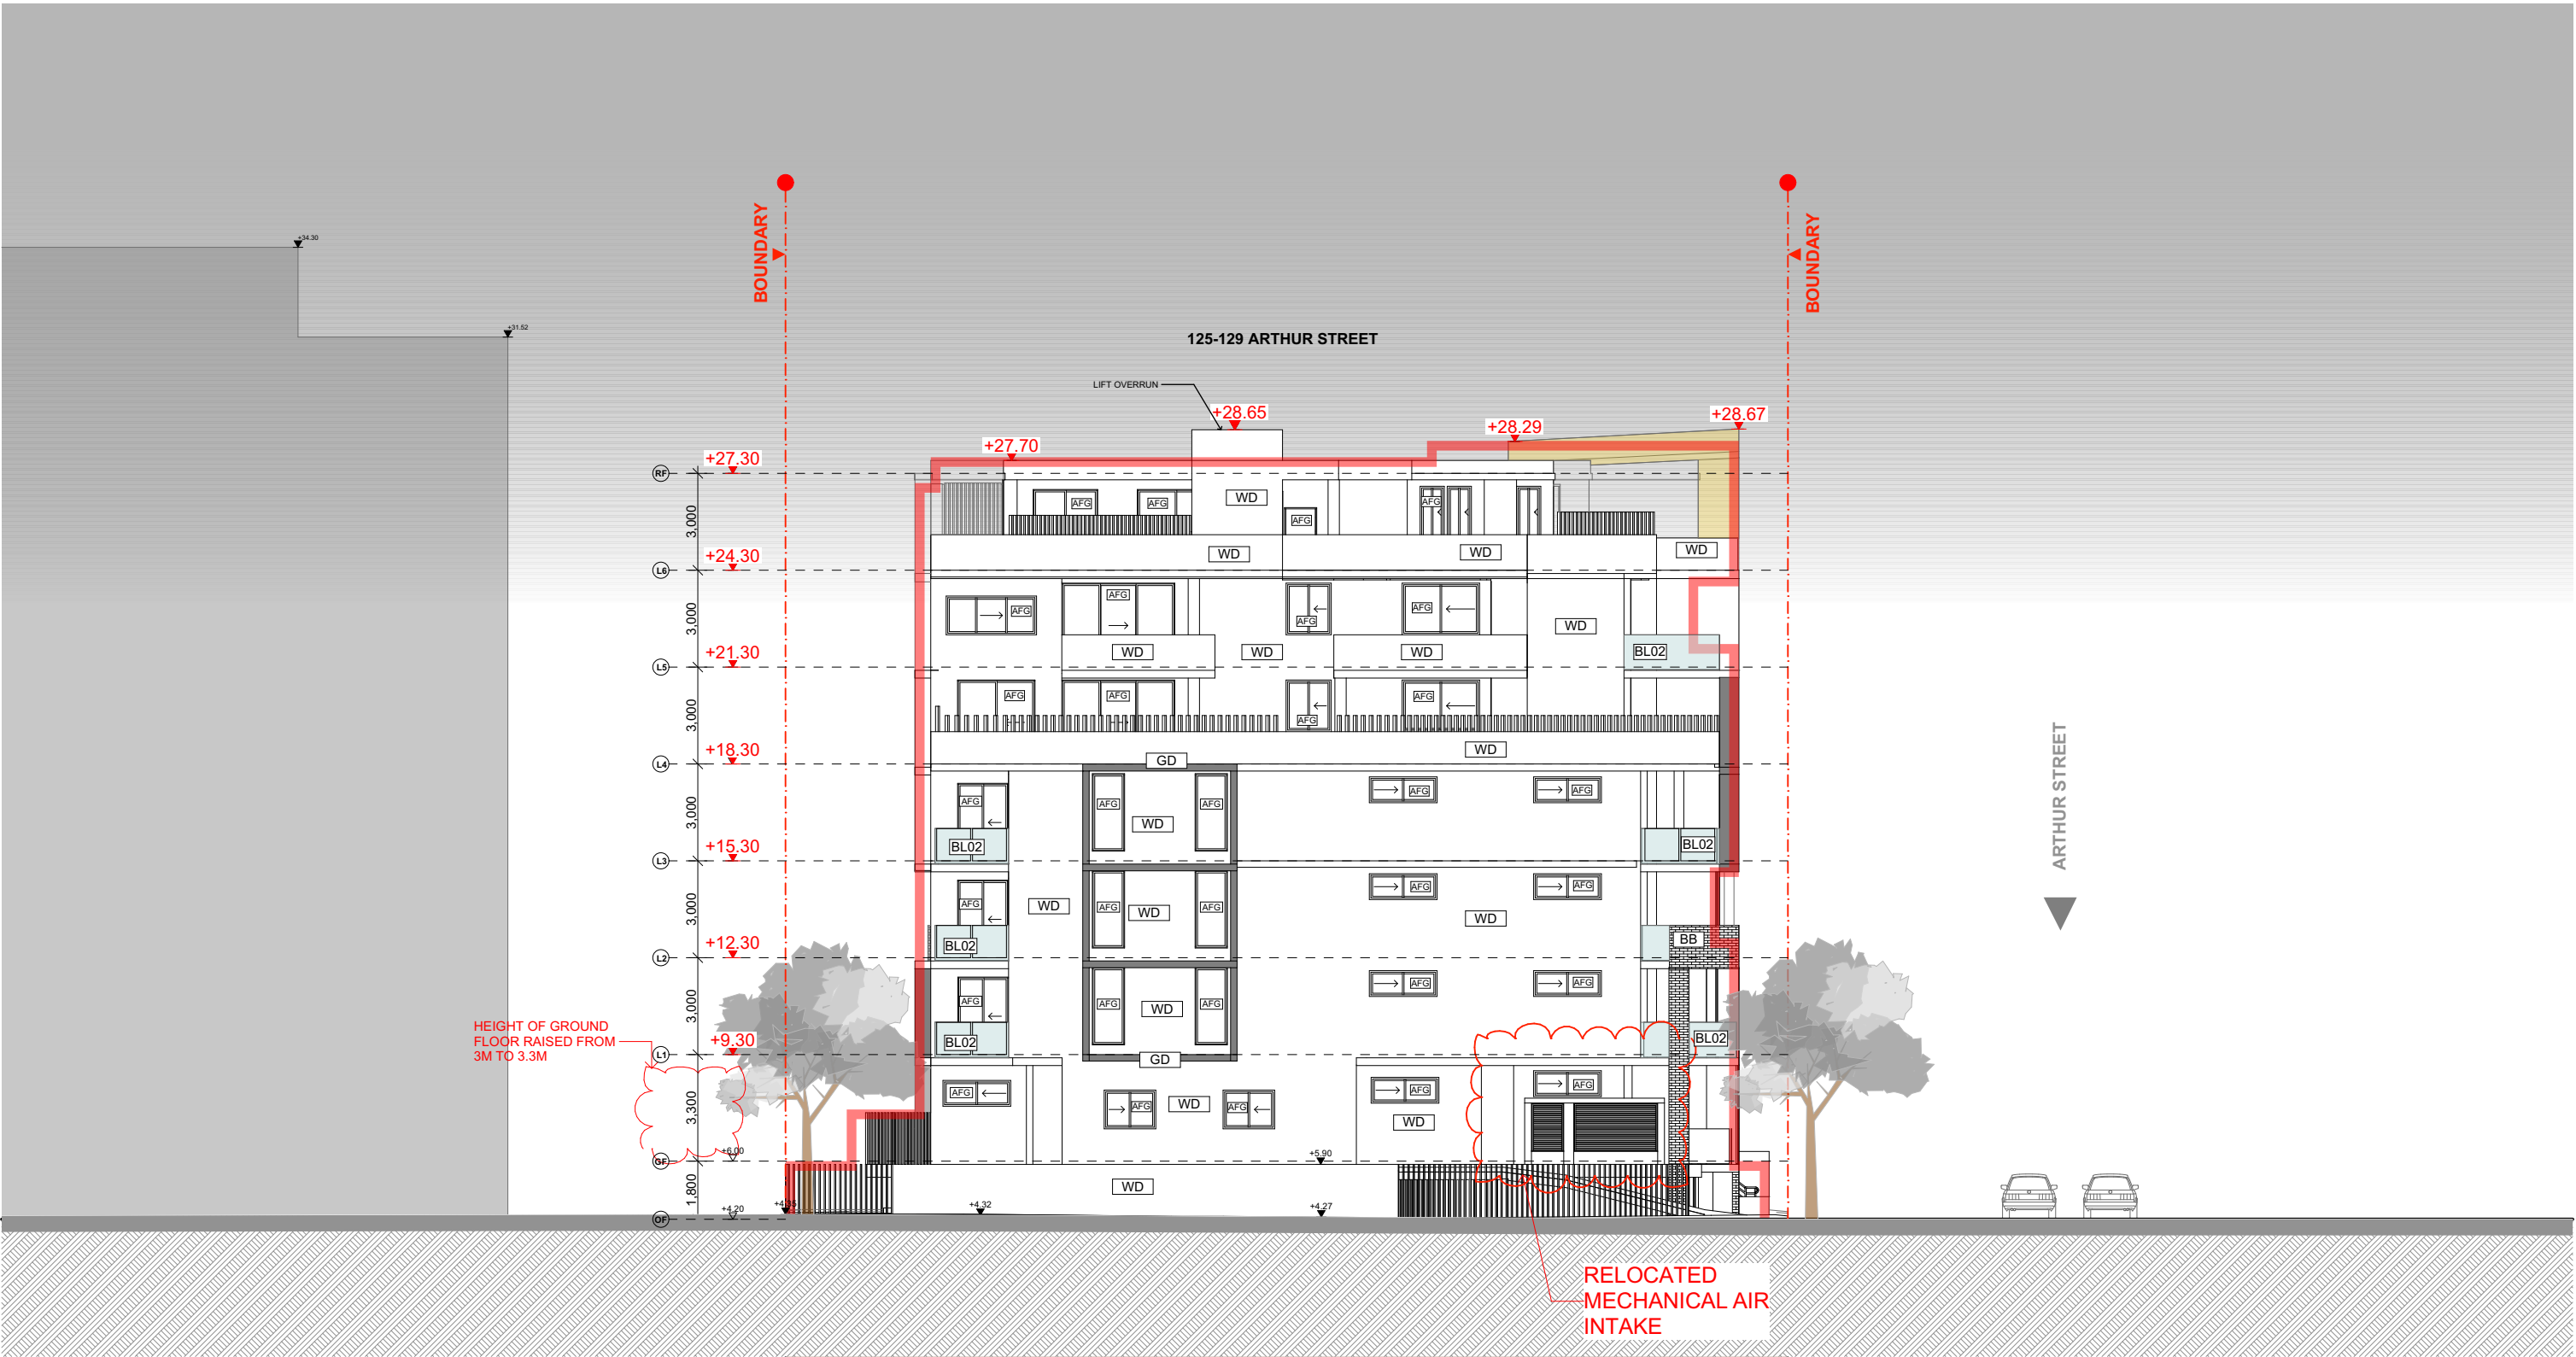

FINISHES LEGEND	
WALLS AND CLADDING	GLAZING / GLAZED SCREENS
BB FACE BRICK	AFG ALUMINIUM FRAMED GLAZING
GD PAINT FINISH TYPE 2 DULUX RAKU or SIMILAR	BL02 GLASS BALUSTRADE
YD PAINT FINISH TYPE 2 DULUX RAPUNZEL	
WD WHITE RENDER(DULUX B 12 VIVID WHITE)	
L ALUMINIUM GREY LOUVER	

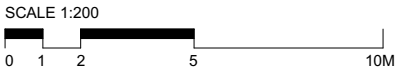

NORTH ELEVATION 1:200 @ A3
APPROVED BUILDING BULK

FOR DA PURPOSES ONLY
NOT FOR CONSTRUCTION
DA

Drawing Original Size
A3

SECTION 96	SECTION 96
27/10/2021	27/10/2021
2018	2018
30/09/2018	30/09/2018
A	A
Issue	Date

© COPYRIGHT

DO NOT SCALE DWGS. USE DIMENSIONS ONLY. REFER ANY DISCREPANCIES TO ARCHITECT PRIOR TO CONSTRUCTION.

THESE DRAWINGS ARE SUBJECT TO COPYRIGHT.

BCA/ ACCESS:

BUILDING INNOVATIONS AUSTRALIA
20th St, 5th Fl, 20th St, Sydney NSW 2010
T: (02) 8014 7700 F: (02) 8014 7701
E: bina@bina.com.au

ACOUSTIC LOGIC
A: 9 Barren St, Mascot NSW 2020 PO Box 208
Mascot NSW 2020
T: (02) 8338 8000 / F: (02) 8338 8399
E: info@acousticlogic.com

STORMWATER:

Sg
415 URBAN PLANNING SOLUTIONS
PO Box 208, Mascot NSW 2020
T: (02) 8338 8000 / F: (02) 8338 8399
E: info@sg.com.au

LANDSCAPING:

CONCEPT
100-110, 100-110 St, Cammeray NSW 2062
T: (02) 9413 8111 / F: (02) 9413 8111
E: info@concept.com.au

PLANNING:

415 URBAN PLANNING SOLUTIONS
PO Box 208, Mascot NSW 2020
T: (02) 8338 8000 / F: (02) 8338 8399
E: info@sg.com.au

SURVEY

SDC
100-110, 100-110 St, Cammeray NSW 2062
T: (02) 9413 8111 / F: (02) 9413 8111
E: info@concept.com.au

SUBSTATION:

AAPOWER ENGINEERING
Commercial 2/25 - 32 Marsh St, Woll Creek
2205
T: (02) 9576 45122
E: aal@aaengineer.com

BASIX


OUTSOURCE IDEAS
PTY LTD
Suite 102, Level 1, 33 Levington Dr
Northmead NSW 2150
T: (02) 9637 9000 / F: (02) 9637 9000
E: info@outsourceideas.com.au

ARCHITECT:


GHAZI AL ALI ARCHITECT PTY LTD
T: +612 9744 7035 | E: office@ghazia.com
ACN: 67167131848
LEVEL 2, OFFICE 2,
14 RAILWAY PARADE, BURWOOD, NSW 2134

PROJECT:	125-129 ARTHUR ST, PARRAMATTA
CLIENT:	ANTHILL CONSTRUCTION PTY LTD
SCALE:	1:200
DATE:	27/10/2021
CAD FILE NUMBER:	
DRAWN BY:	SN
CHECKED 1:	LL
CHECKED 2:	GA
APPROVED:	GA



DRAWING NAME:	NORTH ELEVATION
DRAWING NUMBER:	DA
PROJECT NUMBER:	A-1304
ISSUE:	C

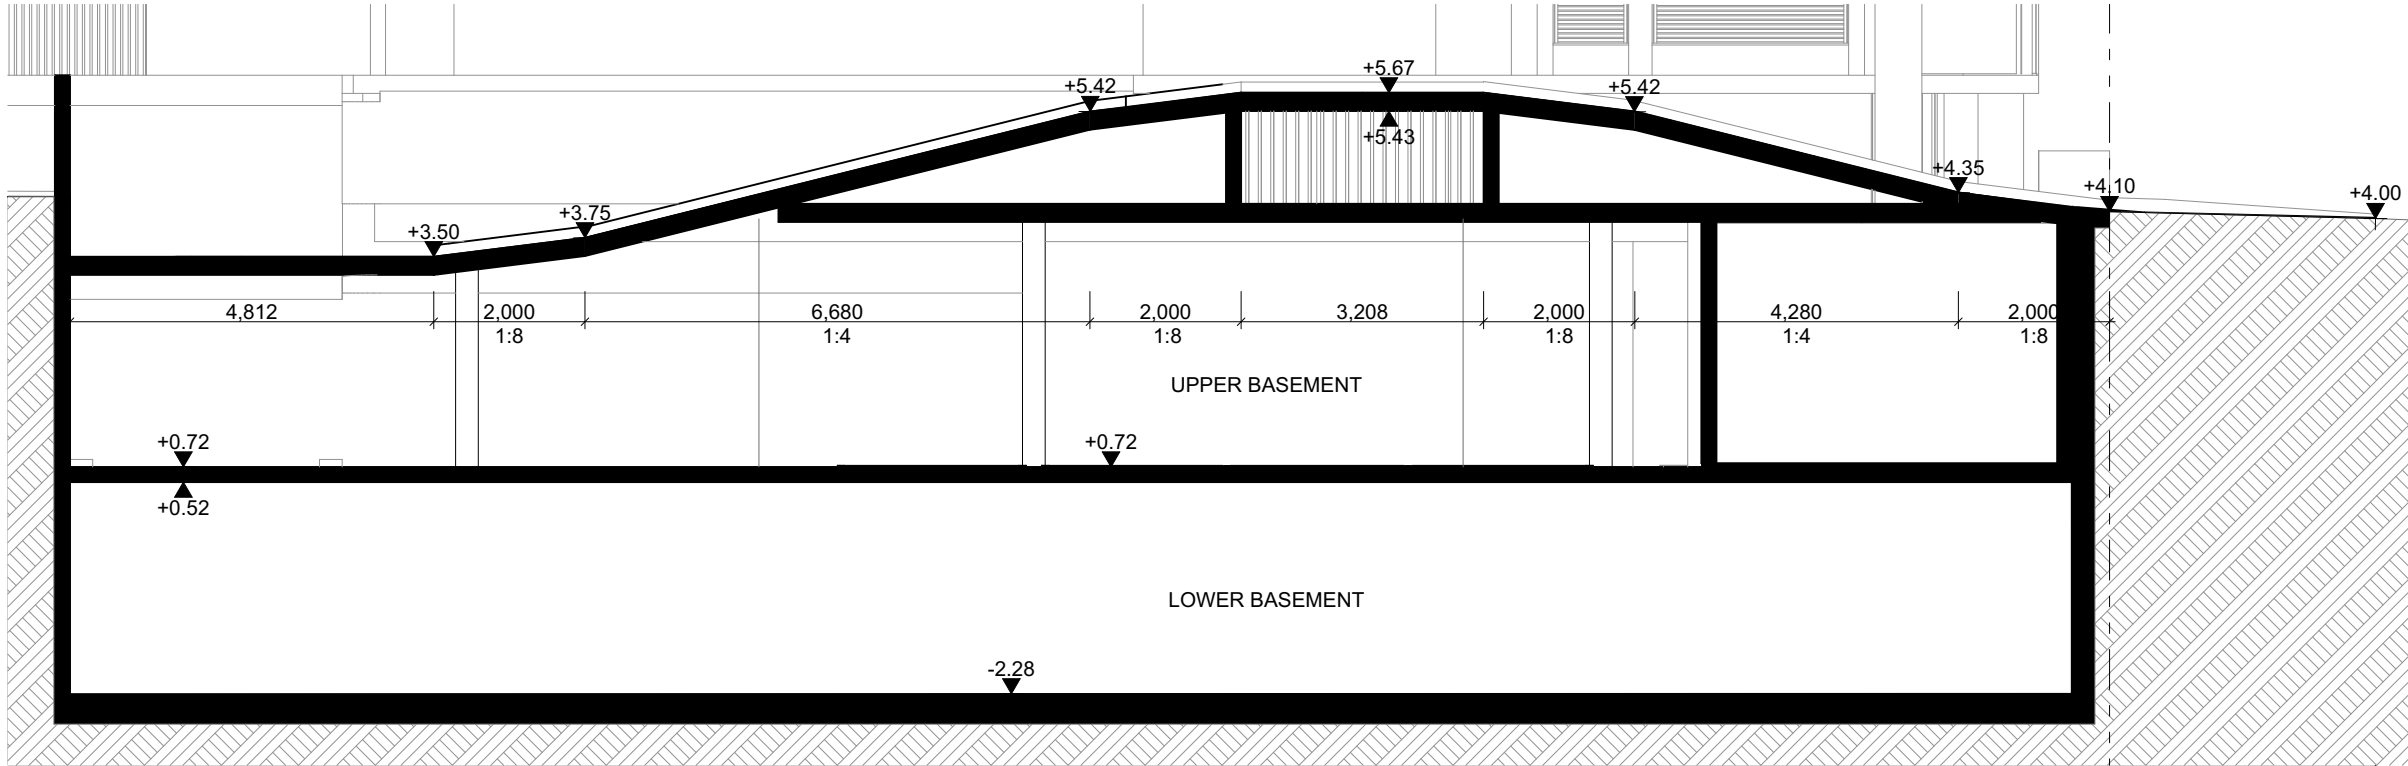


SECTION A 1:100

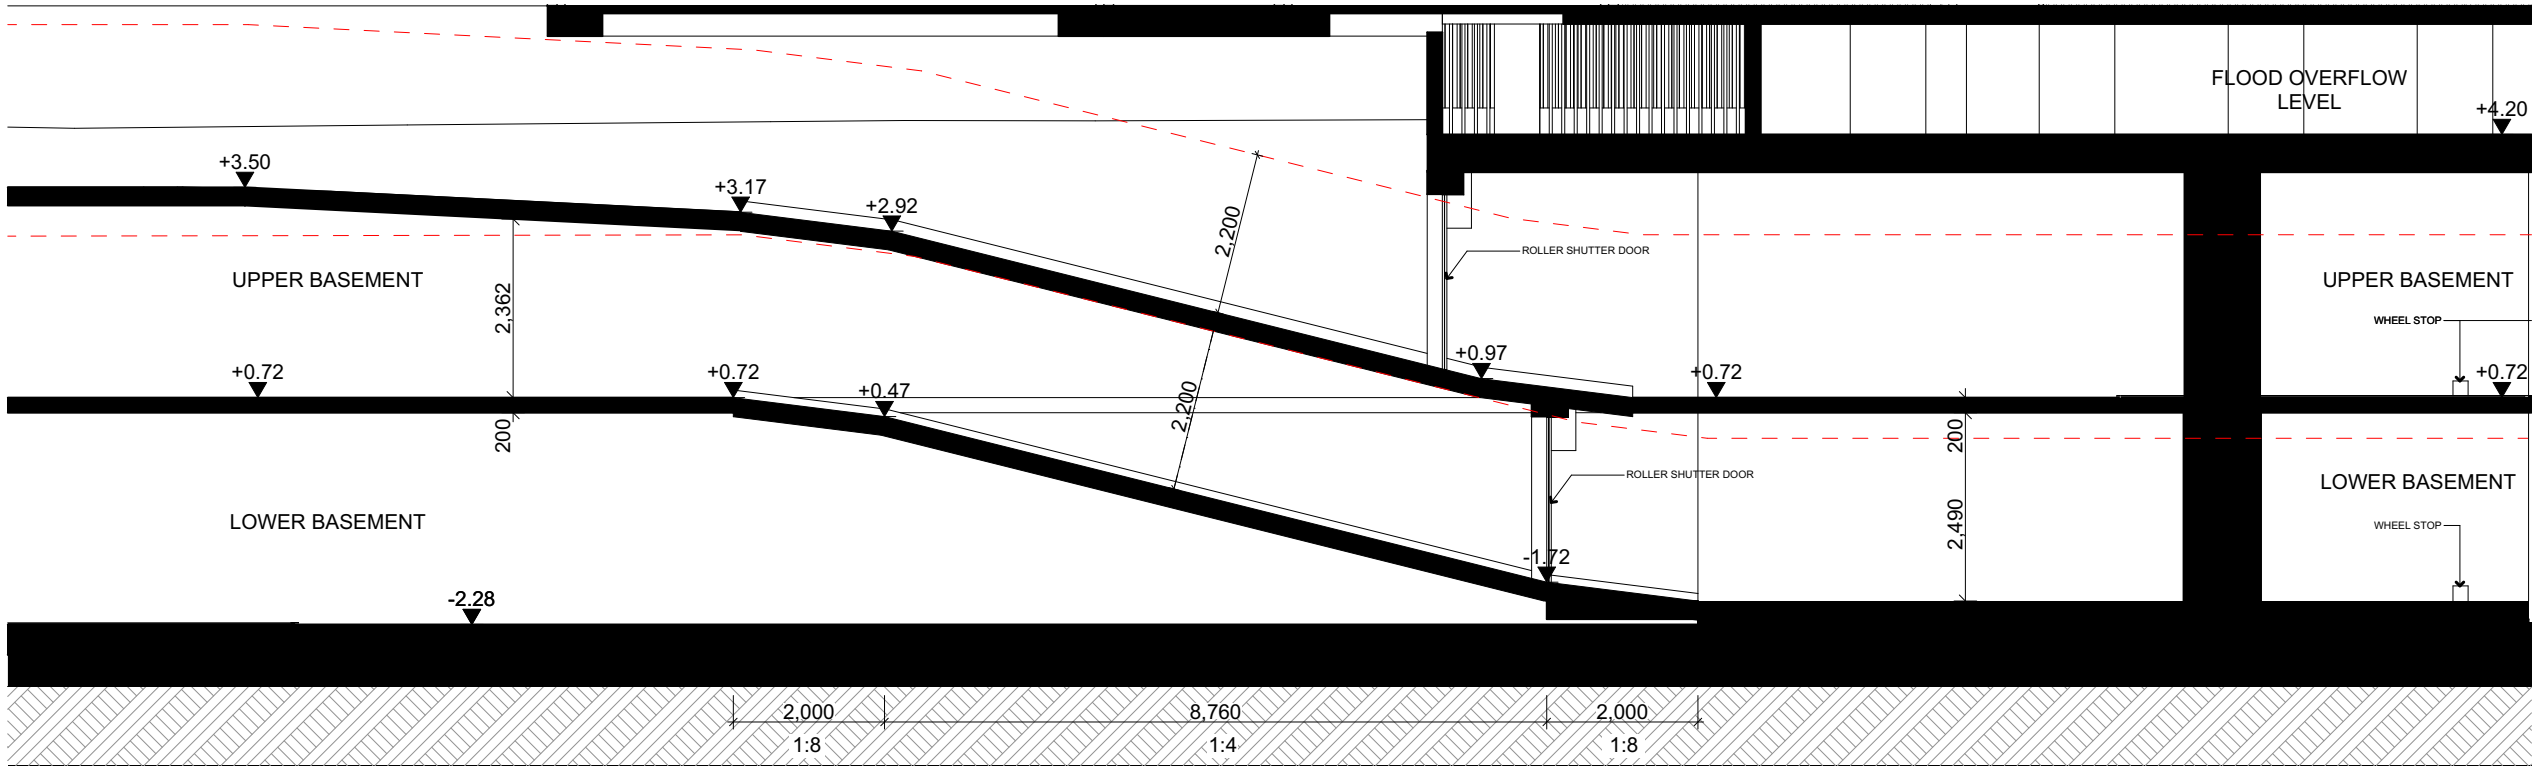

SECTION B 1:100

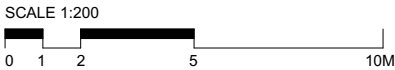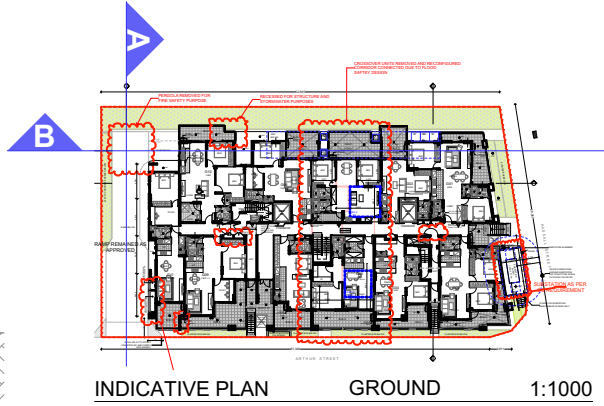

FOR DA PURPOSES ONLY NOT FOR CONSTRUCTION DA		A3 Drawing Original Size	<table><tr><td>C</td><td>27/10/2021</td><td>S4.95</td><td>SECTION 96</td></tr><tr><td>B</td><td>30/09/2018</td><td></td><td>SECTION 96</td></tr><tr><td>A</td><td>30/09/2018</td><td></td><td>SECTION 96</td></tr></table>	C	27/10/2021	S4.95	SECTION 96	B	30/09/2018		SECTION 96	A	30/09/2018		SECTION 96	<p>© COPYRIGHT</p> <p>DO NOT SCALE DWGS. USE DIMENSIONS ONLY. REFER ANY DISCREPANCIES TO ARCHITECT PRIOR TO CONSTRUCTION.</p> <p>THESE DRAWINGS ARE SUBJECT TO COPYRIGHT.</p>		<p>BCA/ ACCESS:</p> <p>BUILDING INNOVATIONS AUSTRALIA 2/26-268, 54-56 Regent Street, Sydney Hills NSW 2150 T: (02) 8014 7700 F: (02) 8014 7701 E: marketing@innovations.net.au</p> <p>ACOUSTIC:</p> <p>ACOUSTIC LOGIC A: 9 Barren St, Mascot NSW 2020 PO Box 208, Mascot NSW 2020 T: (02) 8339 8000 / F: (02) 8338 8399</p>	<p>STORMWATER:</p> <p>Sgc Sustainable Green Communities 415 URBAN PLANNING SOLUTIONS PO Box 218 East Maitland NSW 2323 T: (02) 9576 45122 E: asilac@sgc.com.au</p> <p>LANDSCAPING:</p> <p>CONCEPT LANDSCAPE ARCHITECTS 1/101, 100 Miller St, Cammeray NSW 2050 T: (02) 962 5312 / M: 0413 861 351 E: info@concept.net.au</p>	<p>PLANNING:</p> <p>415 URBAN PLANNING SOLUTIONS PO Box 218 East Maitland NSW 2323 T: (02) 9576 45122 E: asilac@sgc.com.au</p> <p>SURVEY:</p> <p>SDC 1/101, 100 Miller St, Cammeray NSW 2050 T: (02) 962 5312 / M: 0413 861 351 E: info@concept.net.au</p>	<p>SUBSTATION:</p> <p>AAPOWER ENGINEERING Commercial 2/26 - 32 Marsh St, Woll Creek 2205 T: (02) 9576 45122 E: asilac@sgc.com.au</p> <p>BASIX:</p> <p>OUTSOURCE IDEAS PTY LTD Suite 102 Level 3, 33 Lexington Dr Northmead Business Park, Northmead NSW 2153 T: (02) 9576 9000 / M: 0421 530 878 E: info@outsource.net.au</p>	<p>ARCHITECT:</p> <p>GHAZI AL ALI ARCHITECT PTY LTD T: +612 9744 7035 E: office@ghazia.com ACN: 67167131848 LEVEL 2, OFFICE 2, 14 RAILWAY PARADE, BURWOOD, NSW 2134</p>	<p>PROJECT:</p> <p>125-129 ARTHUR ST, PARRAMATTA</p> <p>CLIENT:</p> <p>ANTHILL CONSTRUCTION PTY LTD</p> <p>SCALE:</p> <p>1:100, 1:50, 1:1000</p> <p>DATE:</p> <p>27/10/2021</p> <p>CAD FILE NUMBER:</p> <p></p> <p>DRAWN BY:</p> <p>SN</p> <p>CHECKED 1:</p> <p>LL</p> <p>CHECKED 2:</p> <p>GA</p> <p>APPROVED:</p> <p>GA</p>	<p>DRAWING NAME:</p> <p>RAMP SECTIONS AA & BB</p> <p>DRAWING NUMBER:</p> <p>DA</p> <p>PROJECT NUMBER:</p> <p>92.15</p> <p>ISSUE:</p> <p>C</p>
C	27/10/2021	S4.95	SECTION 96																					
B	30/09/2018		SECTION 96																					
A	30/09/2018		SECTION 96																					

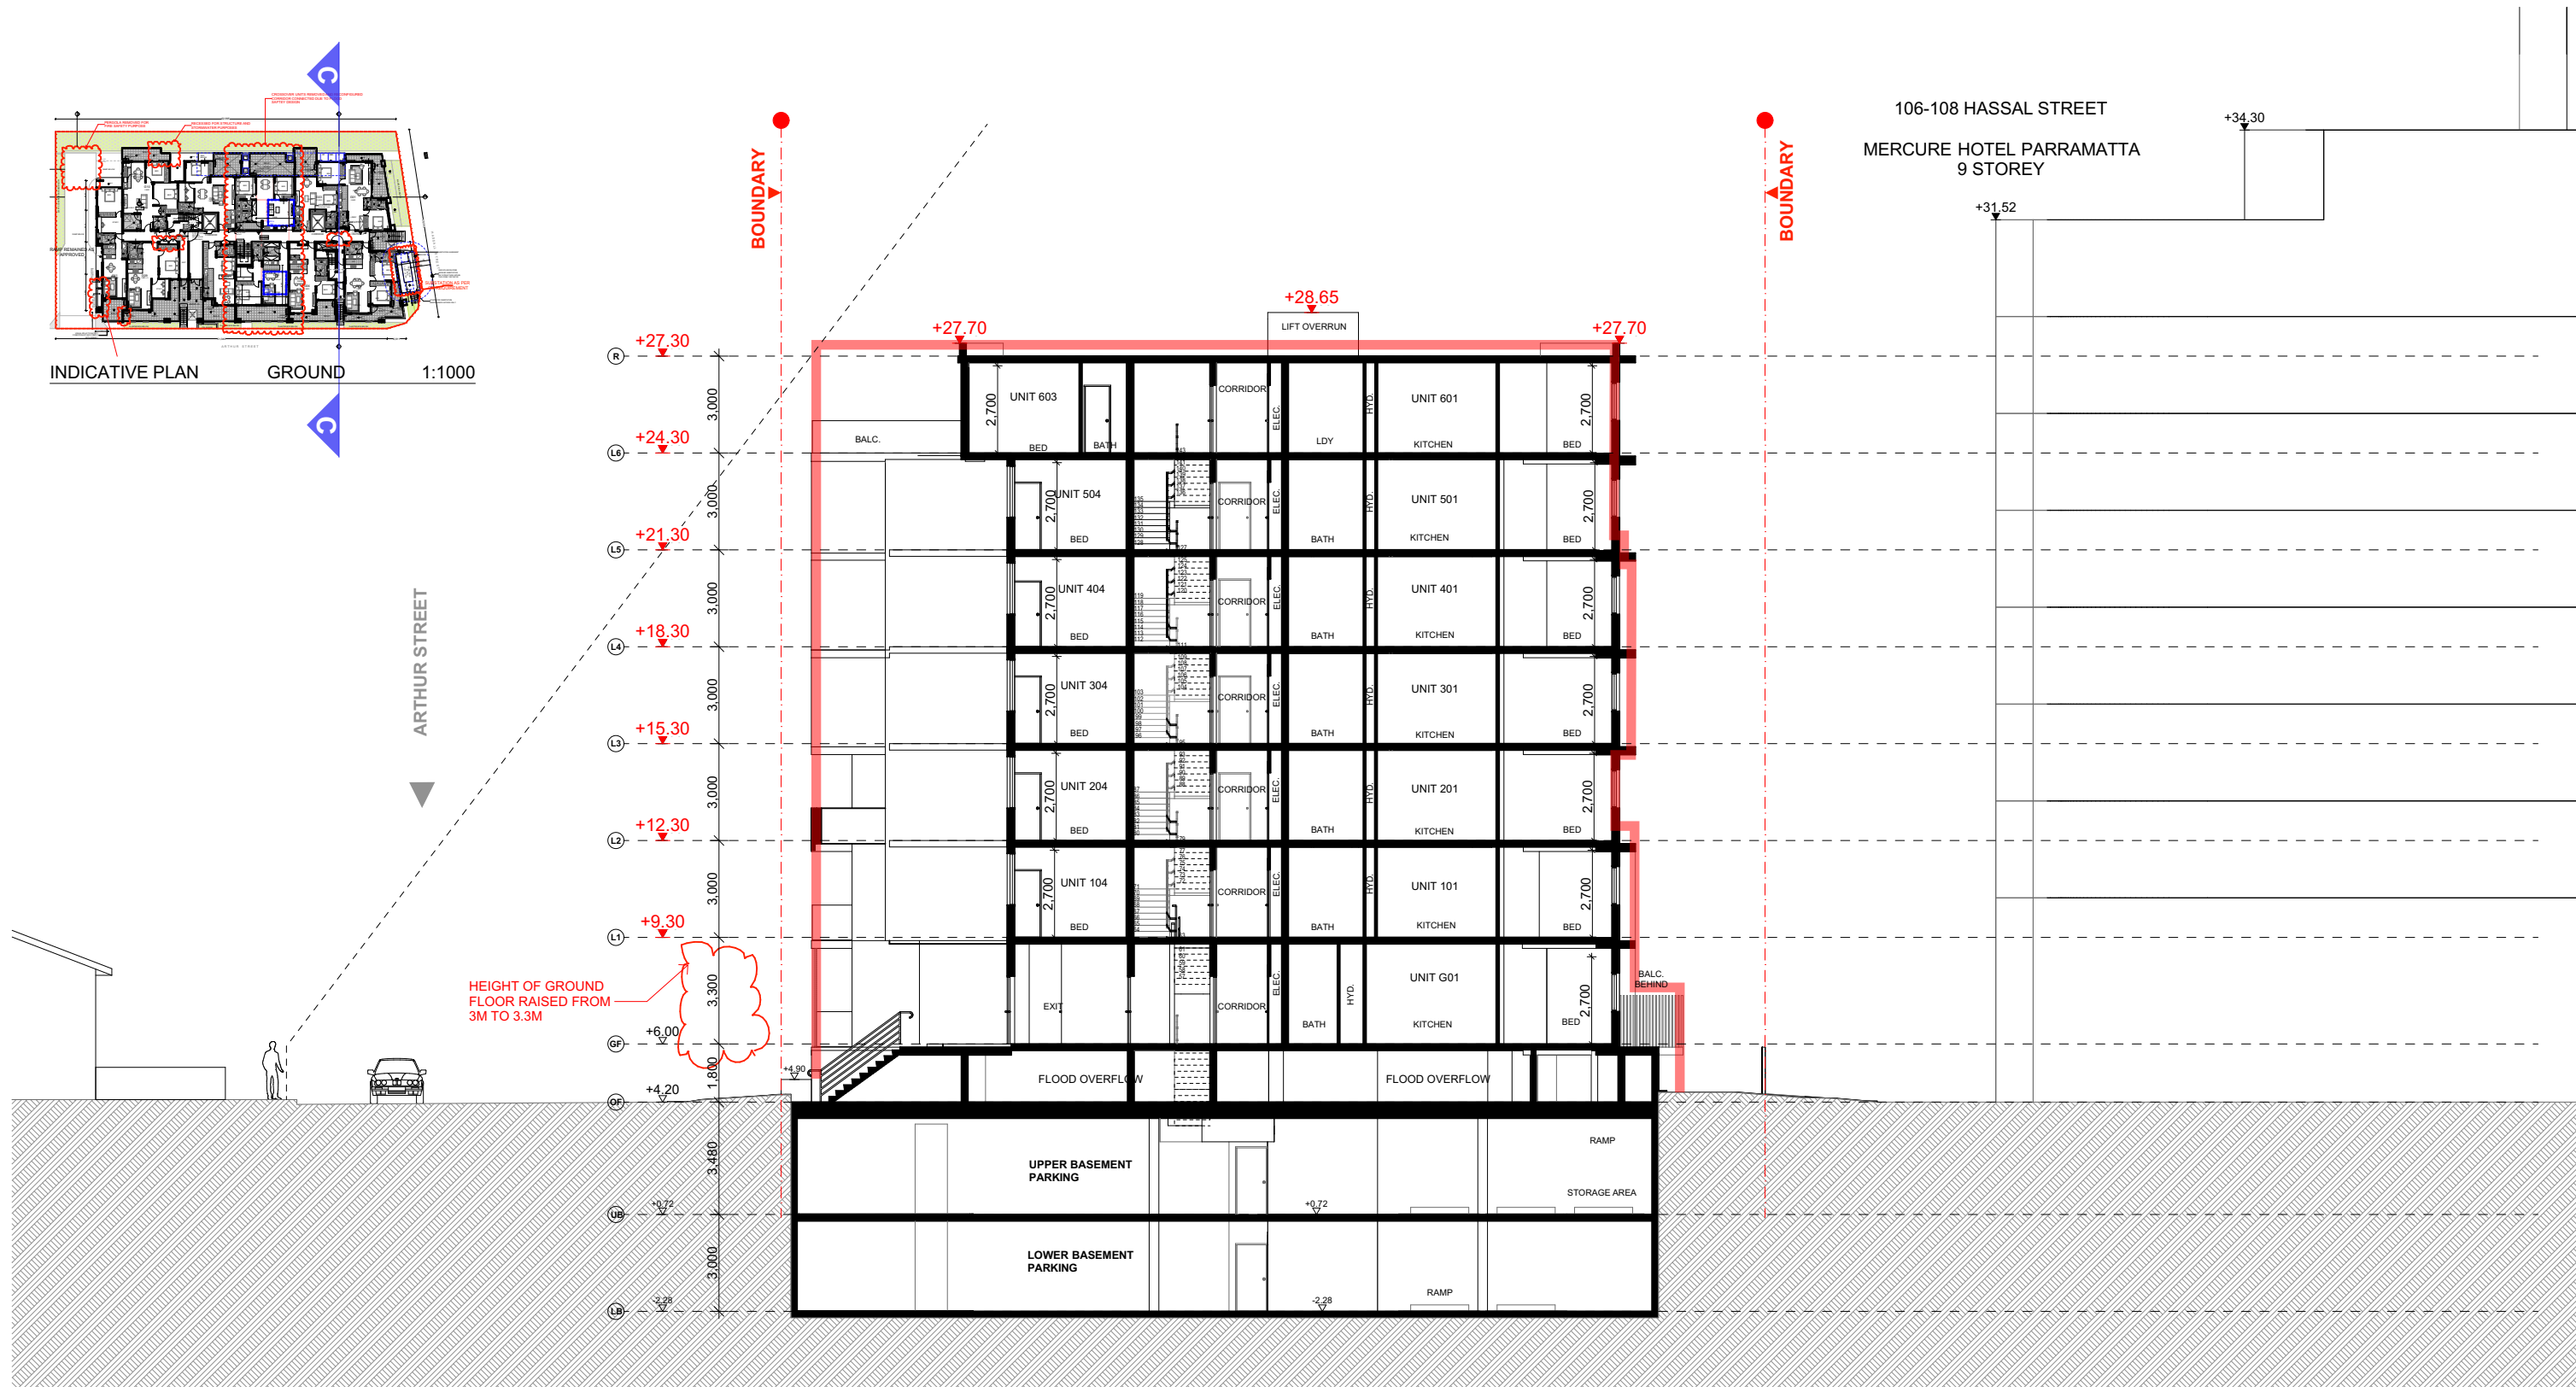

SERVICES UPDATED AS PER CC DESIGN
SUCH AS ADDITION OF HYDRAULIC RISERS/ SERVICE CUPBOARDS
/ MECHANICAL DUCTS

SCALE 1:200
0 1 2 5 10M

FOR DA PURPOSES ONLY
NOT FOR CONSTRUCTION
DA

Drawing Original Size
A3

SECTION 96	SECTION 96
27/10/2021	27/10/2021
2018	2018
2018	2018

© COPYRIGHT

DO NOT SCALE DWGS. USE DIMENSIONS ONLY. REFER ANY DISCREPANCIES TO ARCHITECT PRIOR TO CONSTRUCTION.

THESE DRAWINGS ARE SUBJECT TO COPYRIGHT.

BCA/ ACCESS:

BUILDING INNOVATIONS AUSTRALIA
2/28-30/34-36 Regent Street, Sydney Hills NSW 2150
T: (02) 8014 7700 F: (02) 8014 7701
E: bca@buildinginnovations.net.au

ACOUSTIC LOGIC
A: 9 Bawley St, Mascot NSW 2020 PO Box 208
Mascot NSW 2020
T: (02) 8339 8000 / F: (02) 8339 8399
E: info@acousticlogic.net.au

STORMWATER:

SGC
415 URBAN PLANNING
PO Box 218 East Maitland NSW 2323
T: (02) 9576 45122
E: as@sgc.net.au

LANDSCAPING:

CONCEPT
ARCHITECTS
1/101-103 Miller St, Cammeray NSW 2062
T: (02) 962 0312 / M: 0413 811 351
E: info@concept.net.au

PLANNING:

415 URBAN PLANNING
PO Box 218 East Maitland NSW 2323
T: (02) 9576 45122
E: as@sgc.net.au

SURVEY

SDC
1/101-103 Miller St, Cammeray NSW 2062
T: (02) 962 0312 / M: 0413 811 351
E: info@concept.net.au

SUBSTATION:

AAPOWER ENGINEERING
Commercial 2/28-32 Marsh St, Woll Creek
2205
T: (02) 9576 45122
E: as@sgc.net.au

BASIX

OUTSOURCE IDEAS
PTY LTD
1/101-103 Miller St, Cammeray NSW 2062
T: (02) 962 0312 / M: 0413 811 351
E: info@concept.net.au

ARCHITECT:

GHAZI AL ALI
ARCHITECT
PTY LTD
T: +612 9744 7035 | E: office@ghazia.com
ACN: 67167131848
LEVEL 2, OFFICE 2,
14 RAILWAY PARADE, BURWOOD, NSW 2134

PROJECT:

125-129 ARTHUR ST, PARRAMATTA

CLIENT:

ANTHILL CONSTRUCTION PTY LTD

SCALE:

1:200, 1:1000

DATE:

27/10/2021

CAD FILE NUMBER:

CHECKED 1:

LL

CHECKED 2:

GA

APPROVED:

GA

DRAWING NAME:

SECTION CC

DRAWING NUMBER:


DA

PROJECT NUMBER:

92.15

ISSUE:

C

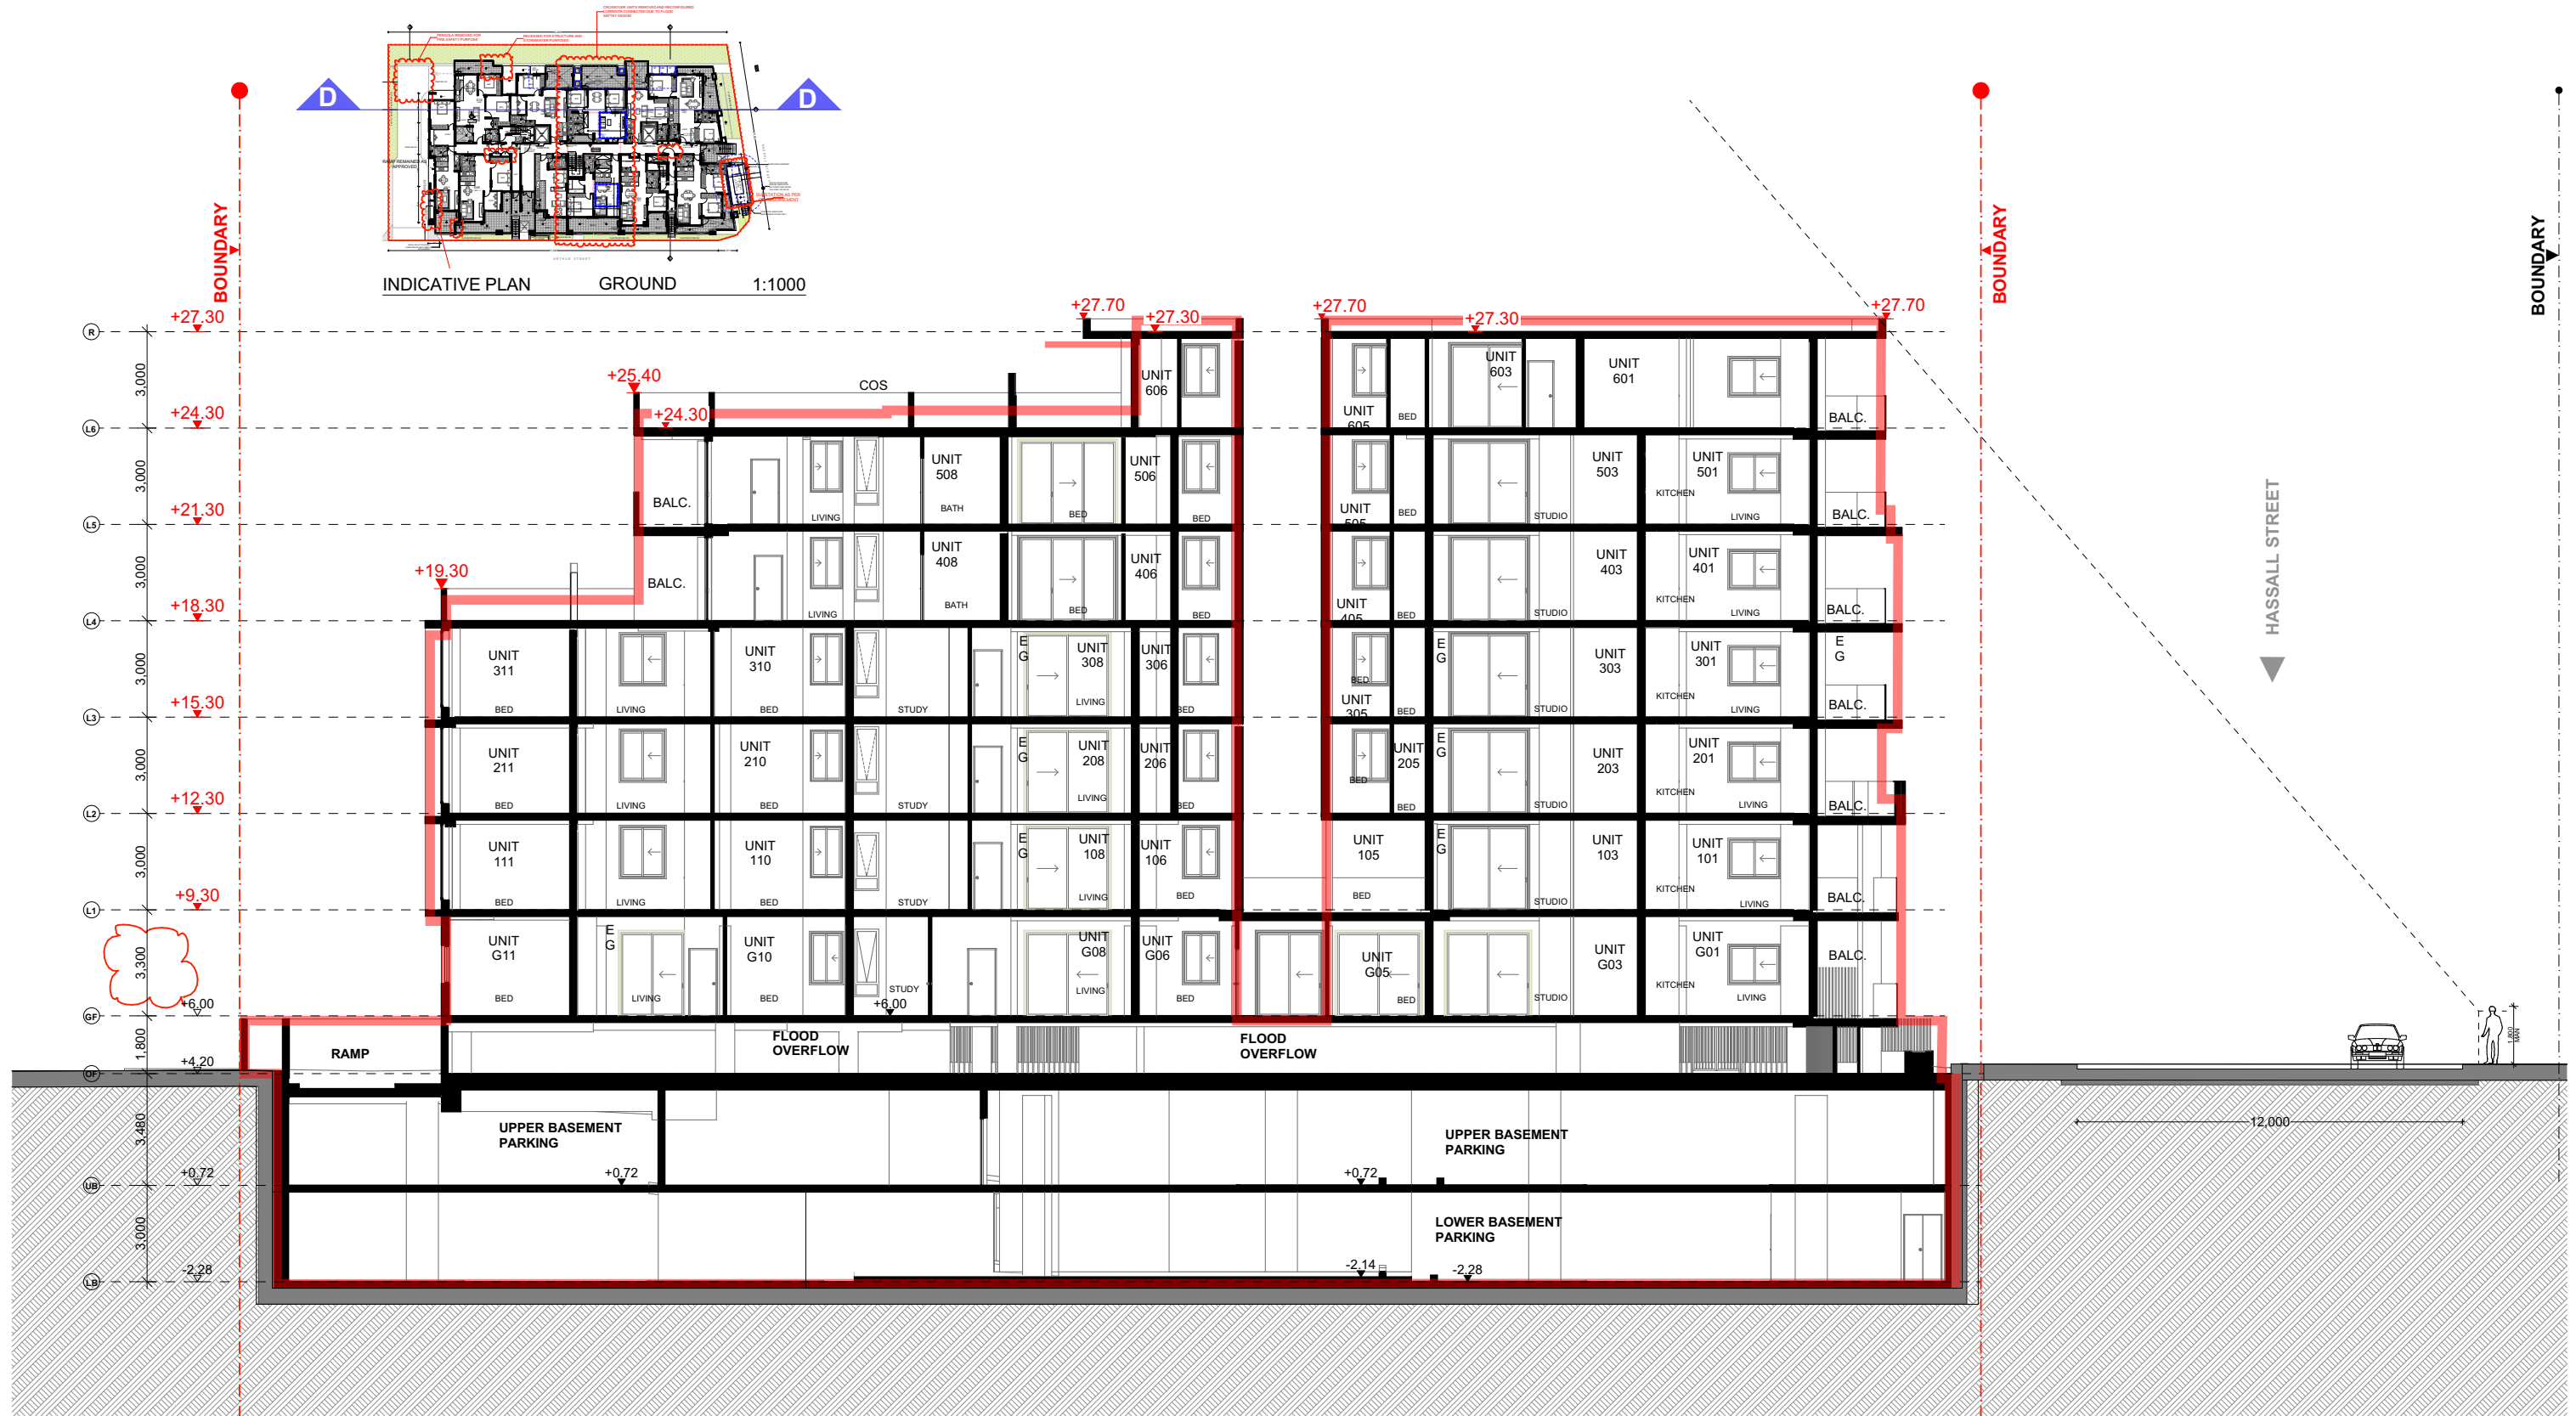

SERVICES UPDATED AS PER CC DESIGN
SUCH AS ADDITION OF HYDRAULIC RISERS/ SERVICE CUPBOARDS
/ MECHANICAL DUCTS

SCALE 1:200
0 1 2 5 10M

FOR DA
PURPOSES ONLY
NOT FOR
CONSTRUCTION
DA

A3
Drawing Original Size

C	27/10/2021	S4.95	SECTION 96	2018	SECTION 96	2018	SECTION 96	2018
B	30/09/2018	S4.95	SECTION 96	2018	SECTION 96	2018	SECTION 96	2018
A	30/09/2018	S4.95	SECTION 96	2018	SECTION 96	2018	SECTION 96	2018

© COPYRIGHT

DO NOT SCALE DWGS. USE DIMENSIONS ONLY. REFER ANY DISCREPANCIES TO ARCHITECT PRIOR TO CONSTRUCTION.

THESE DRAWINGS ARE SUBJECT TO COPYRIGHT.

BCA/ ACCESS:

BUILDING INNOVATIONS AUSTRALIA
20th St, 5th Floor, Sydney, NSW 2000
T: (02) 8014 7700 F: (02) 8014 7701
E: bina@buildinginnovations.com.au

ACOUSTIC:

ACOUSTIC LOGIC
A: 9 Barren St, Mascot NSW 2020 PO Box 208
Mascot NSW 2020
T: (02) 8339 8000 F: (02) 8339 8399
E: info@acousticlogic.com.au

STORMWATER:

SGC
415 URBAN PLANNING
PO Box 208, Mascot NSW 2020
T: (02) 8339 8000 F: (02) 8339 8399
E: info@sgc.net.au

LANDSCAPING:

CONCEPT LANDSCAPE ARCHITECTS
100/102, 100/102 St, Cammeray NSW 2050
T: (02) 9551 5122 F: (02) 9551 5151
E: info@conceptlandscape.com.au

PLANNING:

AAPOWER ENGINEERING
Commercial 2/28 - 32 Marsh St, Woll Creek
2205
T: (02) 9576 45122 F: (02) 9576 45122
E: aapower@aaengineering.com

SUBSTATION:

AAPOWER ENGINEERING
Commercial 2/28 - 32 Marsh St, Woll Creek
2205
T: (02) 9576 45122 F: (02) 9576 45122
E: aapower@aaengineering.com

BASIX:

OUTSOURCE IDEAS
PTY LTD
Suite 20, Level 3, 33 Lexington Dr
Northmead NSW 2150
T: (02) 9576 45122 F: (02) 9576 45122
E: info@outsourcideas.com.au

ARCHITECT:

GHAZI AL ALI ARCHITECT
T: +612 9744 7035 | E: office@ghazi-ali.com
ACN: 67167131848
LEVEL 2, OFFICE 2
14 RAILWAY PARADE, BURWOOD, NSW 2134

PROJECT:

125-129 ARTHUR ST, PARRAMATTA

CLIENT:

ANTHILL CONSTRUCTION PTY LTD

SCALE:

1:200, 1:1000

DATE:

27/10/2021

CAD FILE NUMBER:

SN

CHECKED 1:

LL

CHECKED 2:

GA

APPROVED:

GA

DRAWING NAME:

SECTION DD

DRAWING NUMBER:

DA

PROJECT NUMBER:


92.15

ISSUE:

C

HOT DIP GALVANIZED FLAT BAR, ROD & FIXING
PLATE PAINTED IN DARK GREY MECHANICAL OXIDE;
ALL PARTS WELDED TOGETHER;
FENCE BOLTED TO BUILDING STRUCTURE



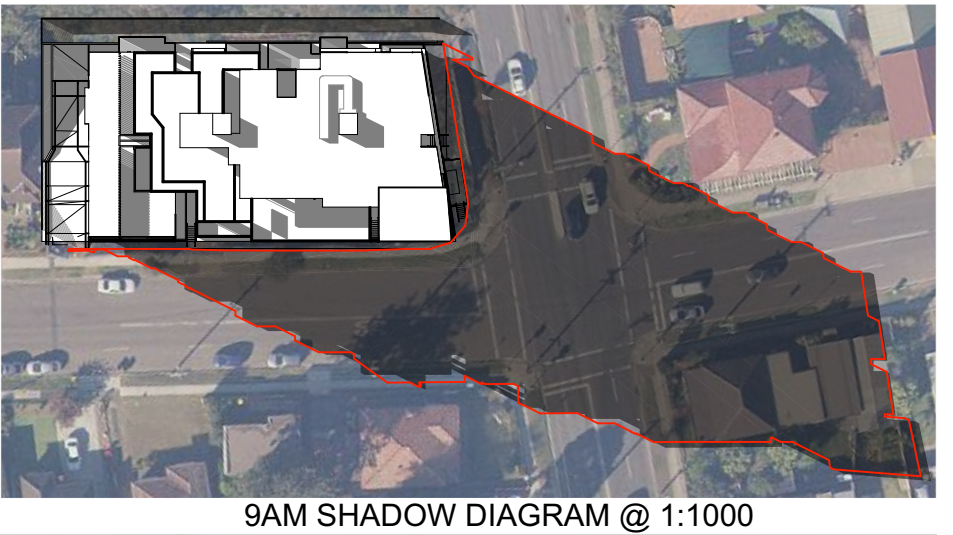



LEGEND

APPROVED BUILDING SHADOW

PROPOSED BUILDING SHADOW

AREA DIFFERENCE

W

WINDOW OF NEIGHBOURING PROPERTY




LOCATION PLAN

Scale: NTS



HARDSCAPE ITEMS

- Street tree tree guard - refer detail
- Garden bed- refer landscape design plan
- Pavers- refer architect's detail
- Decorative gravel over slab - to be nom. by client
- Retaining / raised planter wall - refer detail
- 1.8m Gate and fence - colour and style to be nom. by client
- Trees proposed to be removed and replaced with new landscaping
- Existing trees proposed to be retained and protected

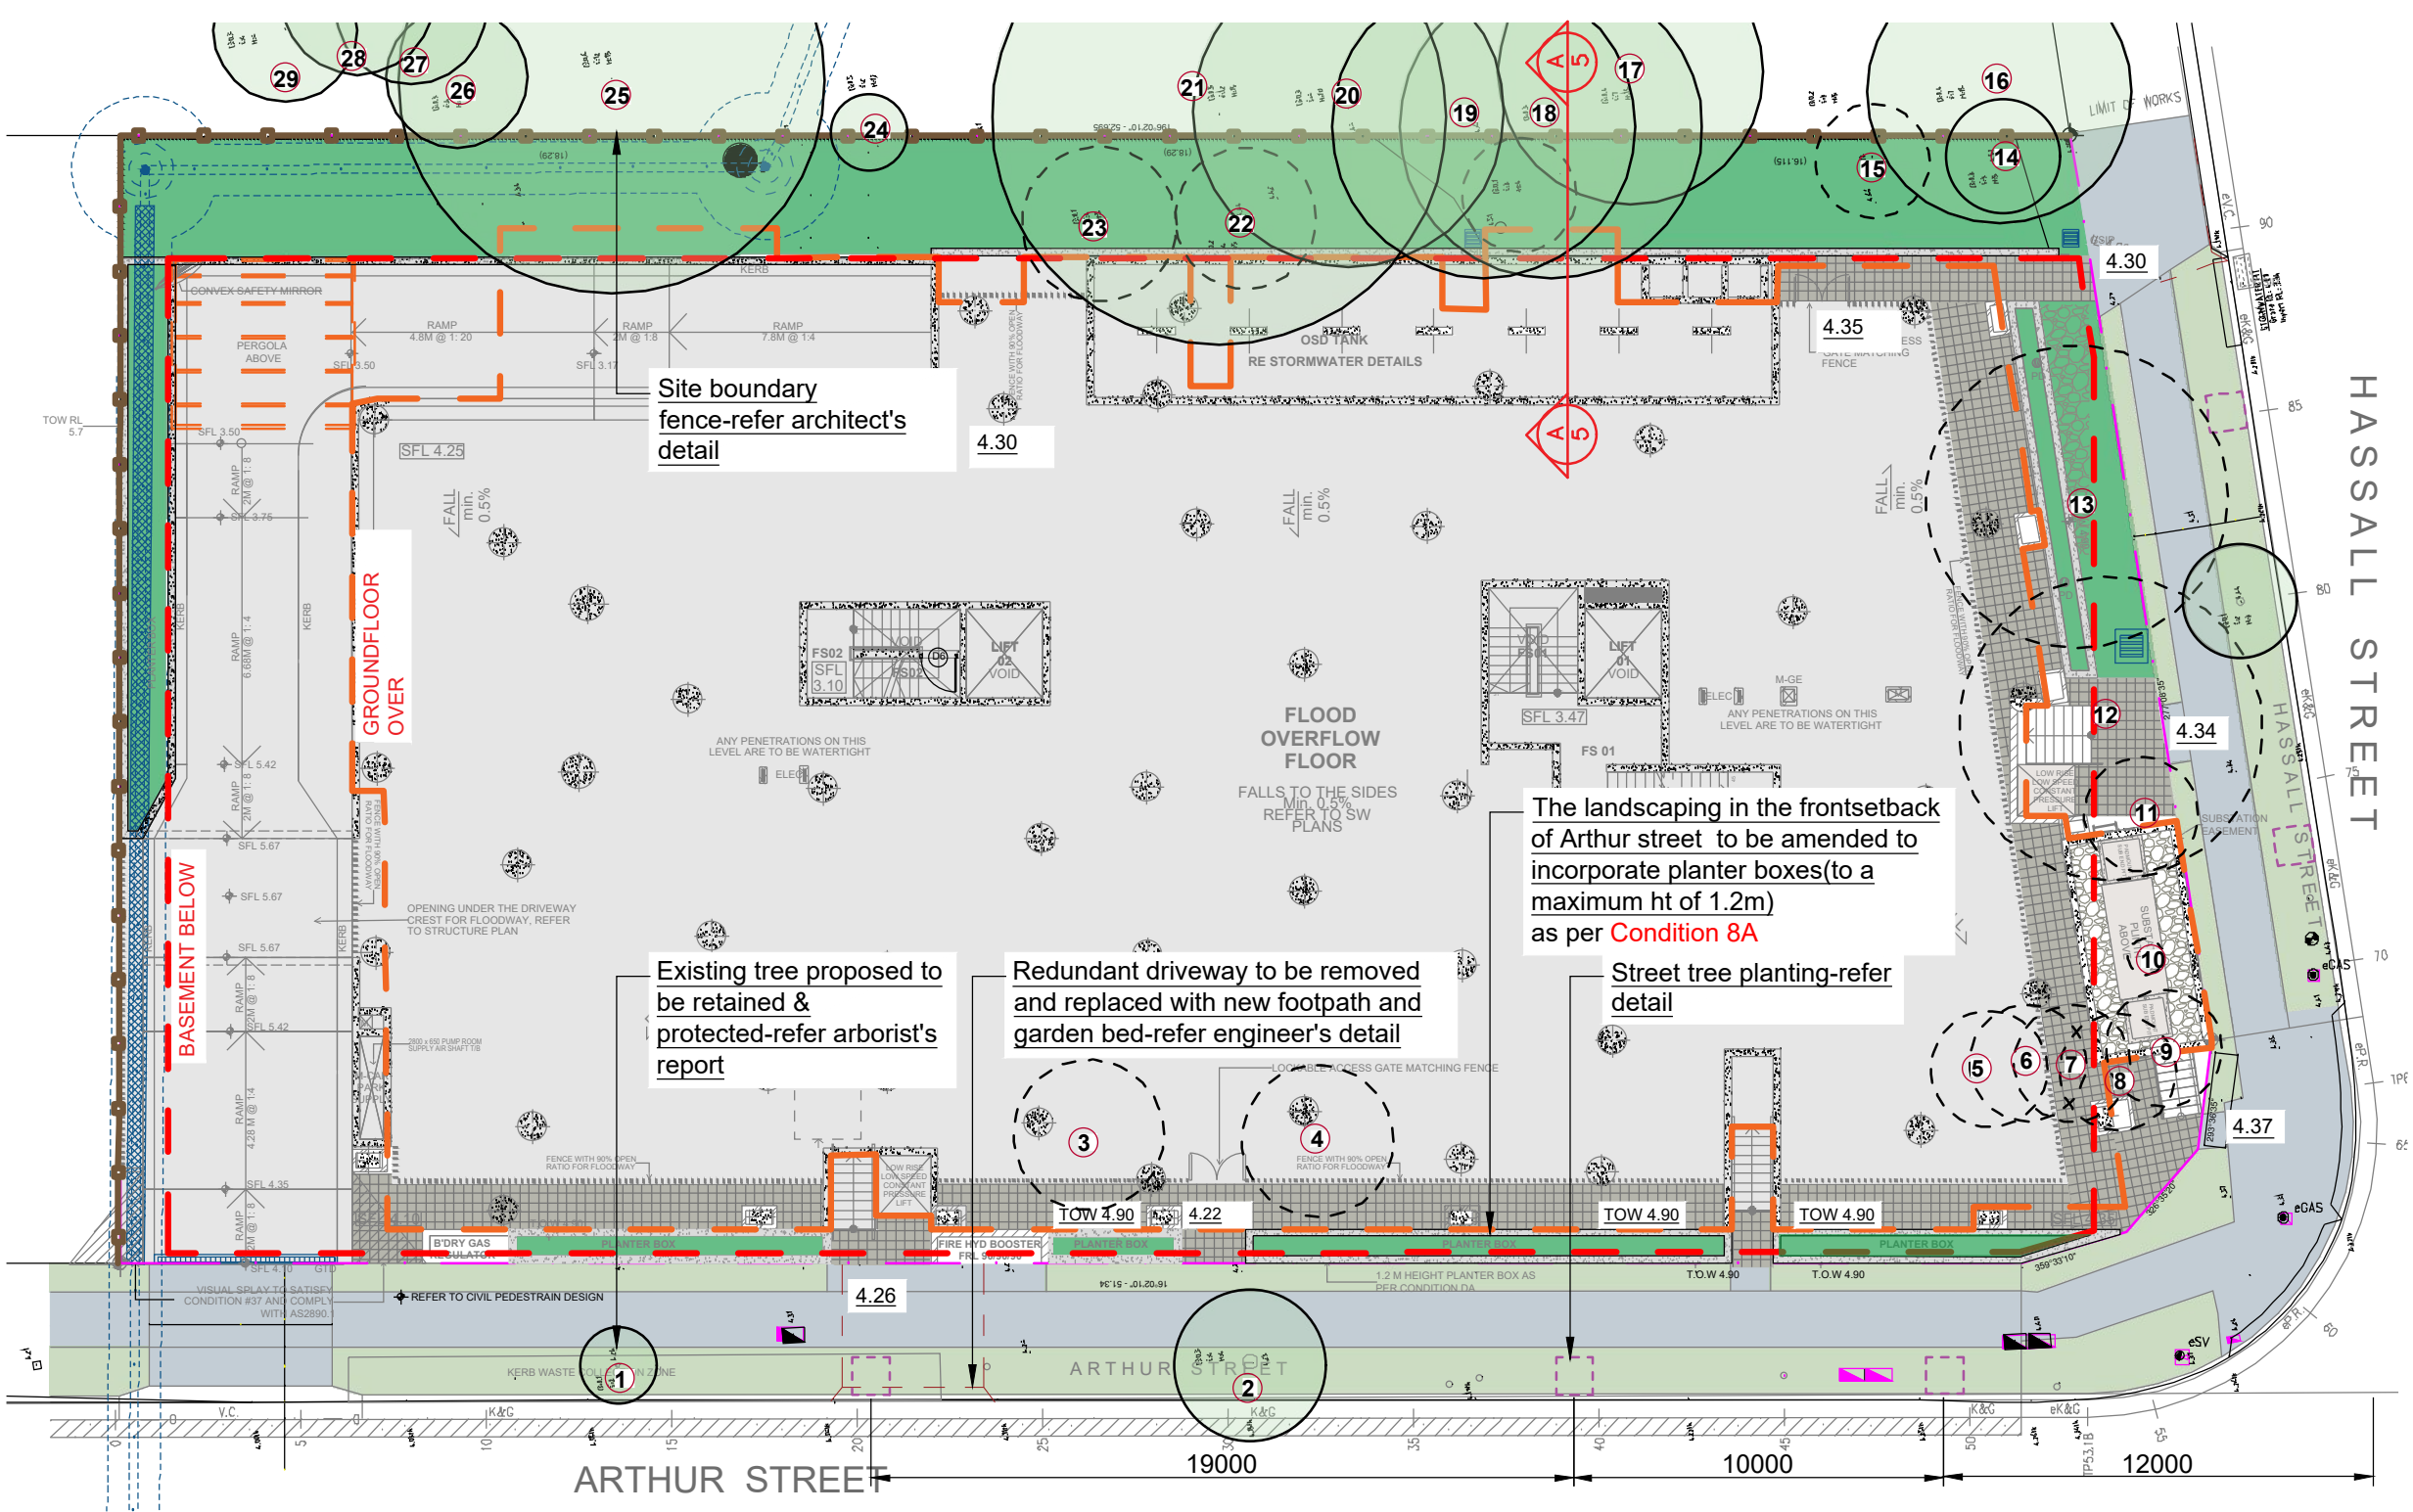

DRAWING SCHEDULE

SHEET #	DRAWING TITLE
/1	HARDSCAPE PLAN
/2	LANDSCAPE PLAN
/3	LANDSCAPE PLAN
/4	DETAILS
/5	DETAILS
/6	SPECIFICATION

TREE SURVEY

REV.

Existing Trees based on Arborists Report by Tree & Landscape consultants dated on 10.12.2014

No.#	Species	Size (Ht x Sp)	Condition	Action
10	Cinnamomum camphora	4x6	Poor	Remove
11	Archontophoenix alexandrae	5x4	Fair	Remove
12	Lophostemon confertus	17x12	Poor	Remove
13	Lophostemon confertus	17x12	Poor	Remove
14	Archontophoenix alexandrae	6x4	Fair	Retain
15	Archontophoenix alexandrae	6x4	Fair	Remove
16	Corymbia maculata	18x14	Fair	Retain
17	Corymbia maculata	17x12	Fair	Retain
18	Casuarina glauca	17x8	Fair	Retain

No.#	Species	Size (Ht x Sp)	Condition	Action
19	Casuarina glauca	17x8	Fair	Retain
20	Corymbia maculata	13x8	Poor	Retain
21	Lophostemon confertus	13x12	Fair	Retain
22	Citris sp.	4x6	Fair	Remove
23	Citris sp.	4x6	Fair	Remove
24	Corymbia maculata	4x6	Fair	Retain
25	Corymbia citriodora	20x24	Poor	Retain
26	Banksia integrifolia	12x6	Fair	Retain
27	Allocasuarina cunninghamiana	12x6	Fair	Retain
28	Allocasuarina cunninghamiana	18x12	Fair	Retain
29	Corymbia maculata	12x8	Poor	Retain

General Notes:

Figured dimensions take preference to scale readings. Verify all dimensions on site. PDF'd plans may vary slightly in scale for that indicated on plans. Report any discrepancies to the Landscape Architect before proceeding with the work.

Copyright Sulphurcrest Enterprises Pty Ltd Trading as CONZEPT (ABN: 75 623 405 630)

This drawing is protected by copyright. All rights are reserved. Unless permitted under the Copyright Act 1968, no part of this drawing may in any form or by any means be reproduced, published, broadcast or transmitted without the prior written permission of the copyright owner.

If the Status of this drawing is not signed off For Construction it may be subject to change, alteration or amendment at the discretion of our office. If so, Concept is not liable for any loss, damage, harm or injury whether special, consequential, direct or indirect, suffered by you or any other person as a result of your use of this drawing for construction purposes.

These plans and associated IP remain the property of Sulphurcrest Enterprises (T/A Concept) until such time as all agreed payments are made in full. We retain the right to withdraw this information from the assessment process if such payments are not made following the notification period.

AILA Associate

www.dialbeforeyoudig.com.au

DIAL 1100 BEFORE YOU DIG

Bar Scale

0 2 4 6 8 10m

REV	DATE	NOTATION/AMENDMENT
A	21.10.2021	Drafted S4.55 plan prepared for review
B	02.11.2021	Issued for S4.55

COUNCIL: PARRAMATTA COUNCIL

CLIENT: ANTHILL CONSTRUCTION

ARCHITECT: GHAZI AL ALI

STATUS / ISSUE: S4.55 - ISSUE B

Conzept Landscape Architects

www.conzept.net.au enquiries@conzept.net.au

Phone: 9922 5312 Suite 101, 506 Miller St CAMMERAY NSW 2062

TITLE: HARDSCAPE PLAN

PROPOSED RESIDENTIAL FLAT BUILDING DEVELOPMENT 125-129 ARTHUR STREET PARRAMATTA

DWG No: LPS4.55 21 - 154 / 1

SCALE: 1:200 @ A3

DATE: NOV 2021

DRAWN: K.Z

CHECKED: R.F

LEGEND & SCHEDULE

NOTES:

1. ALL FINAL PLANT QUANTITIES INDICATED ON PLANS SHALL BE CHECKED AND VERIFIED BY SUCCESSFUL LANDSCAPE CONTRACTOR.
2. ANY PLANT SUBSTITUTES REQUIRED DUE TO UNAVAILABILITY SHALL BE RECOMMENDED BY THE LANDSCAPE CONTRACTOR TO BEST MATCH SUBSTITUTED PLANTS AND APPROVED PRIOR TO PURCHASING BY THE LANDSCAPE ARCHITECT.
3. WORKS CERTIFIED FOR FINAL OCCUPANCY CERTIFICATE ARE TO MATCH APPROVED LANDSCAPE PLANS.
4. LANDSCAPE CONTRACTOR SHALL LOCATE AND AVOID SITE STORM WATER & DRAINAGE SERVICES. LOCATE TREES A MINIMUM 1.25M FROM PITS
5. ALL PLANTING AROUND EXISTING TREES SHALL BE ADJUSTED TO AVOID DAMAGE AND CLASHING WITH SURFACE ROOTS

TREES

TREE SUPPLY STOCK SHALL COMPLY WITH THE GUIDANCE OF NATSPEC,2003 AS PER **CONDITION 96B**

- FOR 100 LT CONTAINER SIZE, HEIGHT (ABOVE CONTAINER) SHALL BE 2.4m; CALIPER (AT 300mm) SHALL BE 50mm; CLEAR TRUNK HEIGHT SHALL BE 1.5m.



Botanical Name: *Eucalyptus sideroxylon* 'Rosea'
Common Name: Red Flowering Ironbark (Native)
Pot size: 100Lt
Mature H x S: 15m+ x 5-8m
Qty Required: 3



Botanical Name: *Lagerstroemia* 'Natchez'
Common Name: Crepe Myrtle (Exotic)
Pot size: 100Lt
Mature H x S: 6m x 4m
Qty Required: 2



Botanical Name: *Elaeocarpus reticulatus*
Common Name: Blueberry Ash (Native)
Pot size: 100Lt
Mature H x S: 8-10m x 6-7m
Qty Required: 9

SHRUBS AND HEDGES



Botanical Name: *Callistemon citrinus* 'Endeavour'
Common Name: Endeavour Bottlebrush (Native)
Pot size: 200mm
Mature H x S: 3m x 2m
Qty Required: 46



Botanical Name: *Syzygium* 'Cascade'
Common Name: Cascade Lilly Pilly (Native)
Pot size: 200mm
Mature H x S: 2.5m x 1.8m
Qty Required: 15



Botanical Name: *Westringia* 'Mundi'
Common Name: B. Gem Coastal Rosemary (Native)
Pot size: 200mm
Mature H x S: 0.5m x 1-1.5m
Qty Required: 20

ACCENT PLANTS



Botanical Name: *Doryanthes excelsa*
Common Name: Gynea Lily (Native)
Pot size: 45L
Mature H x S: 1.1m x 1m
Qty Required: 27



Botanical Name: *Strelitzia juncea*
Common Name: Rush-leaved Strelitzia (Exotic)
Pot size: 200mm
Mature H x S: 1.5m x 1m
Qty Required: 38

GRASSES / GROUNDCOVERS



Botanical Name: *Lomandra longifolia* 'Tanika'
Common Name: Dwarf Mat Rush (Native)
Pot size: 150mm
Mature H x S: 0.8m x 0.8m
Qty Required: 75



Botanical Name: *Dianella tasmanica* 'Tasred'
Common Name: Tasred Flax Lily (Native)
Pot size: 150mm
Mature H x S: 0.6m x 0.65m
Qty Required: 84



Botanical Name: *Hardenbergia* 'Meema'
Common Name: Meema Purple Coral Pea (Native)
Pot size: 140mm
Mature H x S: 0.3m x 1.5m
Qty Required: 5/m2 (47m2 total)

Planting along side boundary to include:
- 15 S. 'Cascade'
- 5.0m2 H. 'Meema'

Planting in deepsoil area to include
- 9 E. reticulatus
- 46 C. citrinus
- 24 D. excelsa
- 56 L. longifolia
- 84 D. tasmanica
- 41.0m2 H. 'Meema'

Street trees to Hassall Street
- 2x 100Lt Lagerstroemia 'Natchez' as per **Condition 96B**

Planting to Hassall street frontage to include:
- 1 E. reticulatus
- 3 D. excelsa
- 14 S. juncea
- 19 L. longifolia
- 1m2 H. 'Meema'

Street trees to Arthur Street to include
3 x 100Lt Eucalyptus sixderoylon as per **Condition 96B**

Planting in raised planter box of Max. 1.2m height along Arthur Street to include:
- 24 S. juncea
- 20 W. 'Mundi'

LANDSCAPE PLAN NOTES

This plan should be read in conjunction with the architectural and hydraulics plans. Work specific to these plans should be prepared in accordance to these plans, including specification and details prior to the installation of landscaping, and should not be altered or compromised during landscape construction. Elements such as drainage swales may be incorporated in garden bed areas (using non-floatable mulch) without compromising the capacity or form.

This plan has been prepared for Section 34 approval only, not for construction.

This plan has been prepared with reference to **Parramatta Council Councils** Landscaping

Guidelines & requirements. Planting proposed using mainly indigenous, commercially available plant species selected from local planting lists and the BASIX local plant list and from Sydney Waters "Plant Selector" web site one-drip rated native plants (**acceptable for Basix planting**).

The Design & location of new letter boxes shall be in accordance with Australia Post's "Requirements for Delivery of Mail to Residential Premises" published Feb '97. All noxious weeds listed in Councils weed lists & located on the site shall be continually removed & suppressed. Reinstate all boundary fencing in poor condition with Council approved 1.8m fencing to rear of building line, rake to 1m forward of BL. Pollution, sediment & erosion control devices as specified shall be in place, and maintained for the duration of the construction period. Proposed excavation near existing established trees to be supervised by arborist

DRAINAGE PITS AND DRAINAGE LINES SHOULD BE LOCATED WITHIN GARDEN AREAS TO ALLOW FOR SITE DRAINAGE WHILE MINIMISING IMPACT ON THE PROPOSED PLANTING SCHEME. WHERE POSSIBLE, PITS AND LINEWORK SHOULD BE LOCATED AT THE EDGE OF LANDSCAPE STRIPS TO AVOID PRECLUDING PLANTING CENTRALLY IN GARDEN AREAS. WHERE PITS AND LINEWORK OCCUR WITHIN GARDEN BEDS, THE LANDSCAPE CONTRACTOR SHALL TAKE ALL PRECAUTIONS TO AVOID DAMAGING STORM WATER WHEN PLANTING SHRUBS AND TREES. LANDSCAPE CONTRACTORS SHALL NOT ALTER THE FORM OF SWALES DESIGNED TO DIRECT OVERLAND FLOW.

 
AN AUTOMATED COMMERCIAL GRADE IRRIGATION SYSTEM SHALL BE PROFESSIONALLY INSTALLED TO ALL GARDEN AREAS, INCLUDING RAISED PLANTERS, UPPER FLOOR PLANTERS AND GARDENS IN NATURAL GROUND. THE SYSTEM SHALL BE DESIGNED AND INSTALLED IN LINE WITH THE IRRIGATION PERFORMANCE SPECIFICATION, BY A LICENCED CONTRACTOR OR LANDSCAPER. THE LICENCED CONTRACTOR SHALL PREPARE AN 'AS BUILT' PLAN OF THE SYSTEM TO THE SUPERINTENDENT FOR STRATA RECORDS, FOR FUTURE MAINTENANCE.

General Notes:
Figured dimensions take preference to scale readings. Verify all dimensions on site. PDF'd plans may vary slightly in scale for that indicated on plans. Report any discrepancies to the Landscape Architect before proceeding with the work.
© Copyright Sulphurcrest Enterprises Pty Ltd Trading as CONCEPT (ABN: 75 623 405 630)
This drawing is protected by copyright. All rights are reserved. Unless permitted under the Copyright Act 1968, no part of this drawing may in any form or by any means be reproduced, published, broadcast or transmitted without the prior written permission of the copyright owner.
If the Status of this drawing is not signed off For Construction it may be subject to change, alteration or amendment at the discretion of our office. If so, Concept is not liable for any loss, damage, harm or injury whether special, consequential, direct or indirect, suffered by you or any other person as a result of your use of this drawing for construction purposes.
These plans and associated IP remain the property of Sulphurcrest Enterprises (T/A Concept) until such time as all agreed payments are made in full. We retain the right to withdraw this information from the assessment process if such payments are not made following the notification period.

AILA Associate



Bar Scale



REV	DATE	NOTATION/AMENDMENT
A	21.10.2021	Drafted S4.55 plan prepared for review
B	02.11.2021	Issued for S4.55

COUNCIL	PARRAMATTA COUNCIL
CLIENT	ANTHILL CONSTRUCTION
ARCHITECT	GHAZI AL ALI
STATUS / ISSUE	S4.55 - ISSUE B




TITLE:
**LANDSCAPE PLAN
-FLOOR OVERFLOW LEVEL
PROPOSED RESIDENTIAL FLAT
BUILDING DEVELOPMENT
125-129 ARTHUR STREET
PARRAMATTA**


DWG.No:	LPS4.55 21 - 154 / 2
SCALE:	1:200 @ A3
DATE:	NOV 2021
DRAWN:	K.Z
CHECKED:	R.F

LEGEND & SCHEDULE

NOTES:
1. ALL FINAL PLANT QUANTITIES INDICATED ON PLANS SHALL BE CHECKED AND VERIFIED BY SUCCESSFUL LANDSCAPE CONTRACTOR.
2. ANY PLANT SUBSTITUTES REQUIRED DUE TO UNAVAILABILITY SHALL BE RECOMMENDED BY THE LANDSCAPE CONTRACTOR TO BEST MATCH SUBSTITUTED PLANTS AND APPROVED PRIOR TO PURCHASING BY THE LANDSCAPE ARCHITECT.
3. WORKS CERTIFIED FOR FINAL OCCUPANCY CERTIFICATE ARE TO MATCH APPROVED LANDSCAPE PLANS.
4. LANDSCAPE CONTRACTOR SHALL LOCATE AND AVOID SITE STORM WATER & DRAINAGE SERVICES. LOCATE TREES A MINIMUM 1.25M FROM PITS
5. ALL PLANTING AROUND EXISTING TREES SHALL BE ADJUSTED TO AVOID DAMAGE AND CLASHING WITH SURFACE ROOTS

TREES

- 

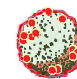Botanical Name: *Banksia serrata*
Common Name: Old man Banksia (Native)
Pot size: 75Lt
Mature H x S: 3-5m x 4-5m
Qty Required: 5
- 

Botanical Name: *Corymbia ficifolia* 'Summer Red'
Common Name: Dwarf Flowering Gum (Native)
Pot size: 75Lt
Mature H x S: 5m x 3m
Qty Required: 6

SHRUBS AND HEDGES

- 

Botanical Name: *Banksia spinulosa* 'Birthday Candles'
Common Name: Banksia Birthday Candles (Native)
Pot size: 200mm
Mature H x S: 0.6m x 0.9m
Qty Required: 7
- 


Botanical Name: *Callistemon* 'Great Balls of Fire'
Common Name: GBOF Bottlebrush (Native)
Pot size: 200mm
Mature H x S: 1.5m x 1.5m
Qty Required: 8
- 


Botanical Name: *Metrosideros* 'Tahiti'
Common Name: NZ Christmas Bush (Exotic)
Pot size: 200mm
Mature H x S: 1m x 1m
Qty Required: 32
- 

Botanical Name: *Westringia fruticosa*
Common Name: Native Rosemary (Native)
Pot size: 200mm
Mature H x S: 1.3m x 1.1m
Qty Required: 25
- 


Botanical Name: *Syzygium* 'Cascade'
Common Name: Cascade Lilly Pilly (Native)
Pot size: 200mm
Mature H x S: 2.5m x 1.8m
Qty Required: 10

ACCENT PLANTS

- 

Botanical Name: *Phormium tenax* 'Purpureum'
Common Name: New Zealand Flax (Exotic)
Pot size: 300mm
Mature H x S: 0.9m x 0.9m
Qty Required: 6
- 

Botanical Name: *Strelitzia juncea*
Common Name: Rush-leaved Strelitzia (Exotic)
Pot size: 200mm
Mature H x S: 1.5m x 1m
Qty Required: 15

- 

Botanical Name: *Yucca filamentosa*
Common Name: Adam's Needle (Exotic)
Pot size: 200mm
Mature H x S: 1.5m x 0.9m
Qty Required: 8

SAMPLE IMAGES

Images are diagrammatic only, and final planting species may vary, as determined by Council Approval



Corymbia ficifolia 'Summer Red'



Banksia serrata



Yucca filamentosa



Metrosideros 'Tahiti'



Banksia spinulosa 'Birthday Candles'



Callistemon 'Great Balls of Fire'



Westringia 'Aussie Box'





Myoporum parvifolium 'Yareena'


Tree Anchoring


For advanced tree planting in high wind and rooftop locations, it is recommended that an approved roof ball anchoring system equal to 'Platipus Anchors' shall be used. Install as per the manufacturers specification'

GRASSES / GROUNDCOVERS

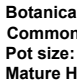- 

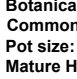
Botanical Name: *Myoporum parvifolium* 'Yareena'
Common Name: Creeping Boobialla (Native)
Pot size: 140mm
Mature H x S: 0.15m x spreading
Qty Required: 7/m2 (12m2 total)
- 

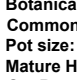
Botanical Name: *Lomandra longifolia* 'Tanika'
Common Name: Dwarf Mat Rush (Native)
Pot size: 150mm
Mature H x S: 0.8m x 0.8m
Qty Required: 31
- 

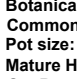
Botanical Name: *Casuarina glauca* 'Cousin It'
Common Name: Cousin It Casuarina (Native)
Pot size: 140mm
Mature H x S: 0.1m x 1.5m
Qty Required: 5/m2 (8.6m2 total)
- 

Botanical Name: *Trachelospermum Jasminoides*
Common Name: Star Jasmine (Exotic)
Pot size: 140mm
Mature H x S: 0.3m x 0.6m
Qty Required: 5/m2 (7m2 total)


HARDSCAPE ITEMS

- 

Retaining / raised planter wall - refer detail
- 

Outdoor dining setting & Outdoor kitchen- to be nom by client to manuf. spec.
- 

Safety balustrade to be applied where is needed

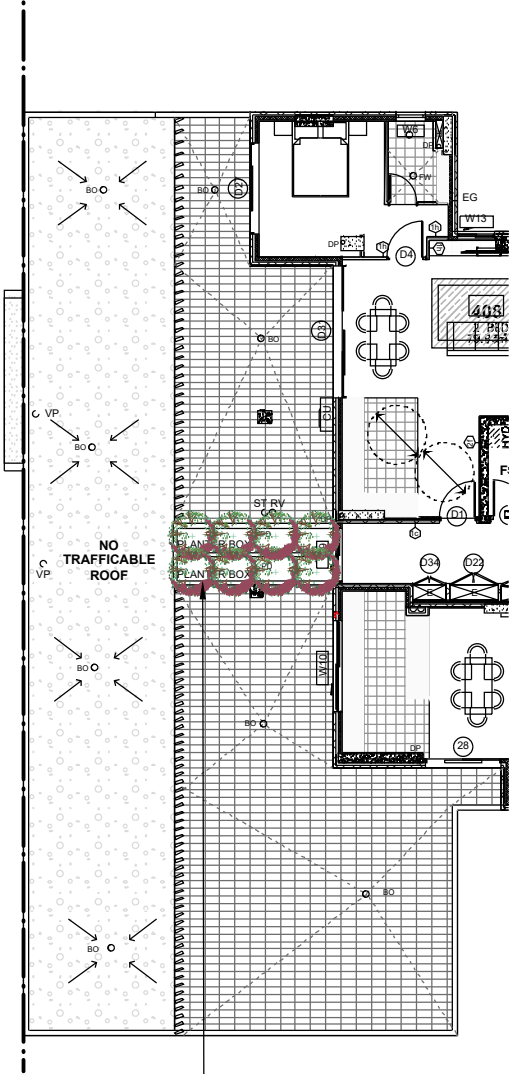

Planting in raised planter to include:
- 8 C. 'Great Balls of Fire'

Planting in raised planter over slab to include:
- 2 B. serrata
- 3 C. 'Summer Red'
- 25 W. fruticosa
- 18 M. 'Tahiti'
- 1 Y. filamentosa
- 6 S. juncea
- 7 B. 'Birthday Candles'
- 20 L. 'Tanika'
- 5 P. 'Purpureum'
- 4.2m2 C. 'Cousin It'
- 9m2 M. 'Yareena'

Planting in raised planter over slab to include:
- 3 B. serrata
- 1 C. 'Summer Red'
- 5 S. 'Cascade'
- 14 M. 'Tahiti'
- 3 Y. filamentosa
- 6 S. juncea
- 6 B. 'Birthday Candles'
- 11 L. 'Tanika'
- 1 P. 'Purpureum'
- 4.4m2 C. 'Cousin It'
- 3m2 M. 'Yareena'

Outdoor dining setting & Outdoor kitchen to be nom. by client

Planting in raised planter over slab to include:
- 5 S. 'Cascade'
- 4 Y. filamentosa
- 3 S. juncea
- 7m2 T. Jasminoides

Retaining / raised planter wall -refer detail
Min. height achieve BCA + AS for safety or approved & certified balustrade to be applied if needed

Communal Open Space Rooftop Terraces
GENERAL NOTE

BCA & Australian Standards (AS):

Building codes and standards are established on a federal level by the nationally recognised Building Code of Australia (BCA), & these apply to all phases of construction, including balustrade design and specification. Specifically, BCA 2012 Parts 3.9.1 (stairs) and 3.9.2 (balustrades) and Australian Standard 1170.1 cover regulations for balustrades on stairways, balconies, rooftop terraces and other surfaces between levels.

BCA Balustrade Regulations and Standards

A balustrade is defined as a rail and its balusters (posts or other supporting members). BCA regulations state that a balustrade must:

- Be at least 1 metre high as measured from the finished floor;
- Have openings between risers or posts no greater than 125mm; and
- Be able to withstand loads and impacts as determined by AS 1170.1

The height regulation of 1 metre ensures the balustrade is high enough to provide prevention against falling over the balustrade. The openings between risers or posts cannot be greater than 125mm to prevent children from falling between them. Load and impact regulations are designed to ensure balustrades can resist impact or will not collapse when pressure is applied to them from any direction.

Balustrade Safety & Planters

BCA regulations state that the balustrade must be 1 metre or more, higher than the finished floor. On roof-top terraces, planters & furniture are often incorporated in the landscape design. It's important for compliance and safety that these elements do not undermine the safety of Communal Open Space (COS) terraces and rooftops, and the compliance with the BCA and AS's are maintained.

Items to consider are:

- Where planters form the safety balustrade, their internal face must be 1m non-climbable
- Outdoor furniture such as tables, BBQs, and seating shall be fixed and located a minimum 1m away from balustrades
- Where furniture is proposed to be fixed or adjacent to COS terrace planters which form the balustrade, then a compliant handrail will be required to be fixed to the external edge of the planter

A concern for COS areas on rooftops or terrace areas is that the strata will add loose furniture which ultimately could undermine the safety of the installed balustrades. In this case, it shall be the strata bodies responsibility to manage the safety of these areas.

Ultimately, the compliance and safety of the COS areas shall be the responsibility of the builder, and carefully inspected and certified at the Occupation Certificate (OC) stage of the development

Maintenance of COS area


Communal Open Space terrace and rooftop areas are exposed to extremes (wind, sun, and extreme weather) so maintenance is important. The following item should be included or considered:

- All planters shall be structurally water-proofed, with this work certified and periodically inspected. Trades should be closely monitored so they do not subsequently damage completed waterproofing
- All planters shall be irrigated with an automated system set on an approved watering pattern. Moisture gauges should be installed in some planters to minimize overwatering
- Tree Anchors shall be installed in high wind areas to larger plants, such as palms & small trees
- Compliance for balustrades and handrails should be monitored regularly
- For the maintenance of large rooftop areas and planters without external balustrades, anchoring points for tying off harnesses for landscape maintenance workers are essential

General Notes:
Figured dimensions take precedence to scale readings. Verify all dimensions on site. PDF'd plans may vary slightly in scale for that indicated on plans. Report any discrepancies to the Landscape Architect before proceeding with the work.
© Copyright Sulphurcrest Enterprises Pty Ltd Trading as CONZEPT (ABN: 75 623 405 630)
This drawing is protected by copyright. All rights are reserved. Unless permitted under the Copyright Act 1968, no part of this drawing may in any form or by any means be reproduced, published, broadcast or transmitted without the prior written permission of the copyright owner.
If the Status of this drawing is not signed off For Construction it may be subject to change, alteration or amendment at the discretion of our office. If no Concept is not liable for any loss, damage, harm or injury whether special, consequential, direct or indirect, suffered by you or any other person as a result of your use of this drawing for construction purposes.
These plans and associated IP remain the property of Sulphurcrest Enterprises (T/A Concept) until such time as all agreed payments are made in full. We retain the right to withdraw this information from the assessment process if such payments are not made following the notification period.

AILA Associate

www.dialbeforeyoudig.com.au

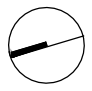
Bar Scale
0 2 4 6 8 10m


REV	DATE	NOTATION/AMENDMENT
A	21.10.2021	Drafted S4.55 plan prepared for review
B	02.11.2021	Issued for S4.55

COUNCIL PARRAMATTA COUNCIL
CLIENT ANTHILL CONSTRUCTION
ARCHITECT GHAZI AL ALI
STATUS / ISSUE S4.55 - ISSUE B


www.conzept.net.au
enquiries@conzept.net.au
Phone: 9922 5312
Suite 101, 506 Miller St
CAMMERAY NSW 2062

TITLE: LANDSCAPE PLAN	DWG No: LPS4.55 21 - 154 / 3
PROPOSED RESIDENTIAL FLAT BUILDING DEVELOPMENT 125-129 ARTHUR STREET PARRAMATTA	SCALE: 1:200 @ A3
	DATE: NOV 2021
	DRAWN: K.Z
	CHECKED: R.F

OVERFLOW
(TO SUPPLIER'S
SPECIFICATION)




NOTE (BCA COMPLIANCE).
WHERE NO EXTERNAL
BALUSTRADE IS PROPOSED.
THE INTERNAL PLANTER WALL
FACE MUST BE NON-CLIMBABLE
TO A HEIGHT TO MEET AS &
BCA COMPLIANCE.


**NOTE.(DRAINAGE & WATER
PROOFING).**
DRAINAGE PITS AND LAYOUT TO BE
NOMINATED BY HYDRAULIC
ENGINEER TO WORK WITH
STRUCTURAL DESIGN AND
LANDSCAPE.

THE WATERPROOFING, APPROVED
DRAINAGE CELL AND SPECIFIED
GEOFABRIC LAYER IN THIS DETAIL
ARE INDICATIVE ONLY AND SHOULD
BE DETAILED BY THE RELEVANT
PROFESSIONAL ENGINEER 'FOR
CONSTRUCTION'.

UNDER THE CONSTRUCTION
PRACTITIONER BILL, STRUCTURAL
WATER-PROOFING SHALL BE
DOCUMENTED BY A HYDRAULIC
ENGINEER

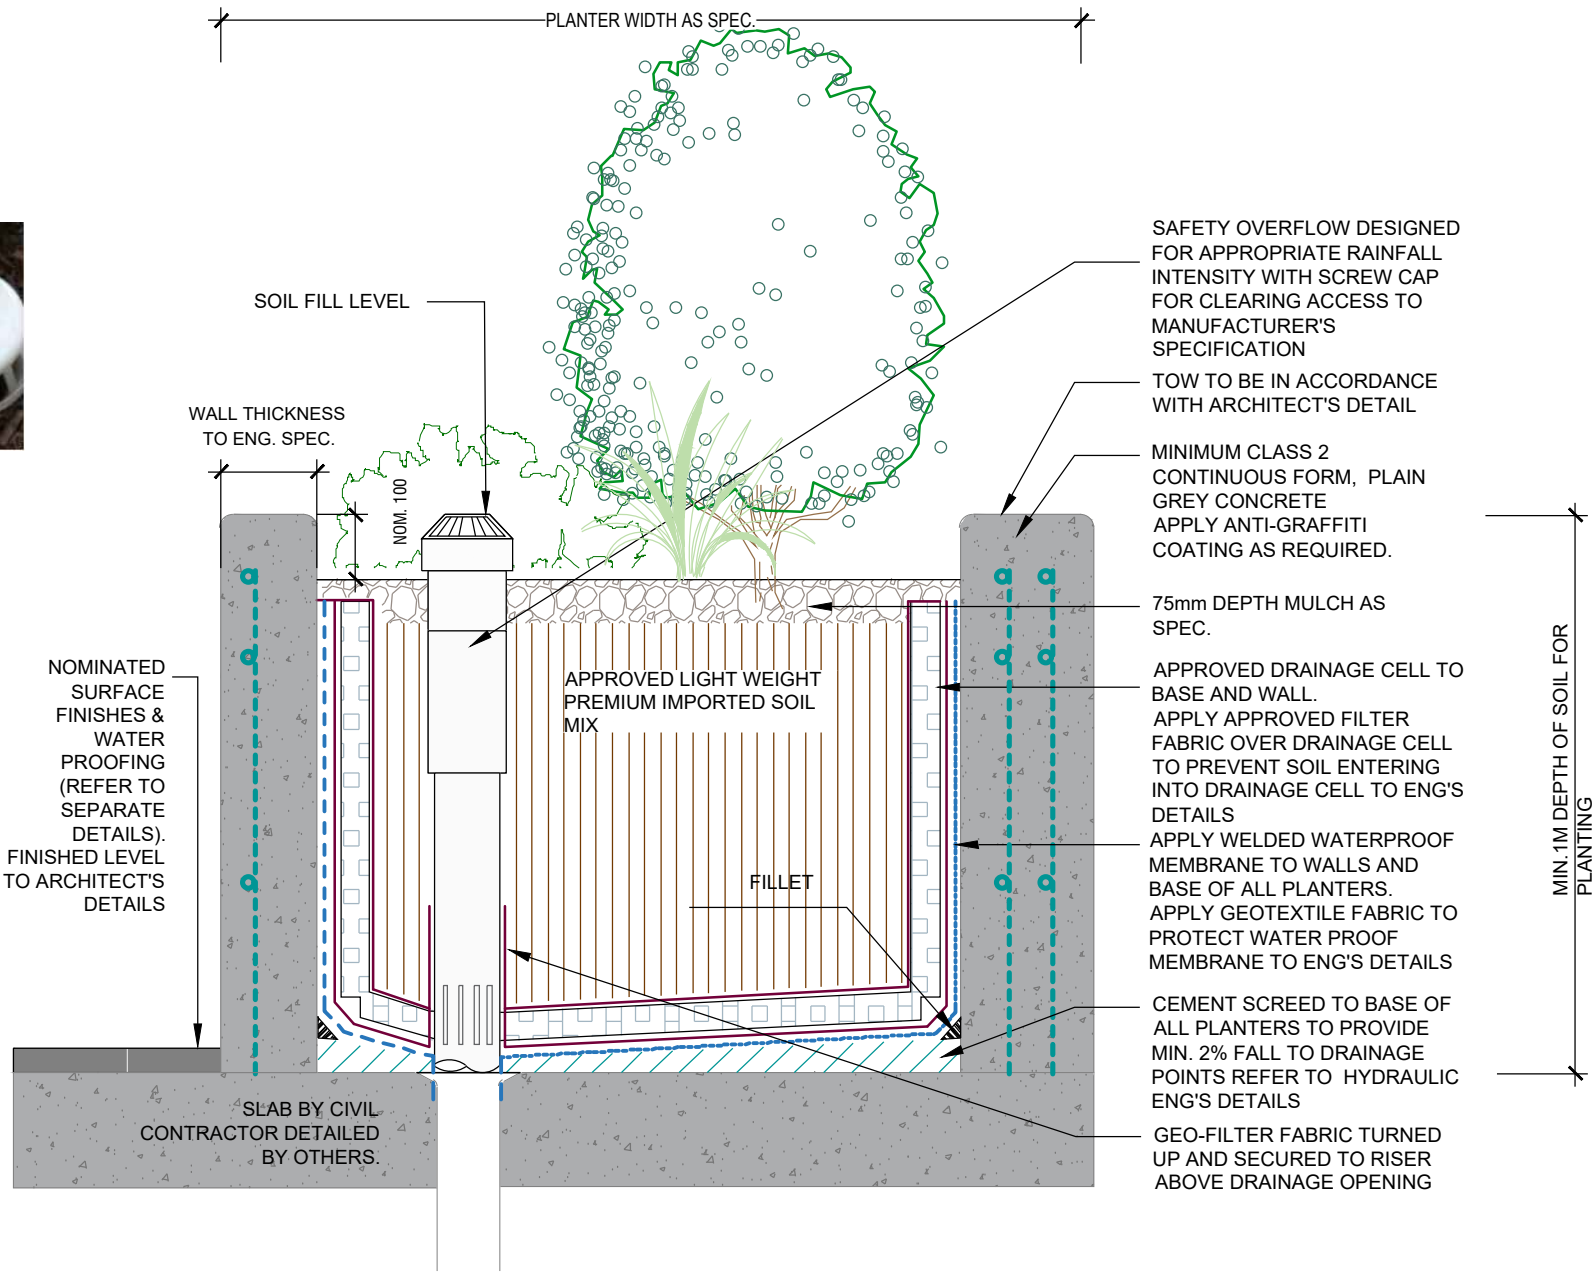

RAISED PLANTER OVER SLAB
SCALE N.T.S

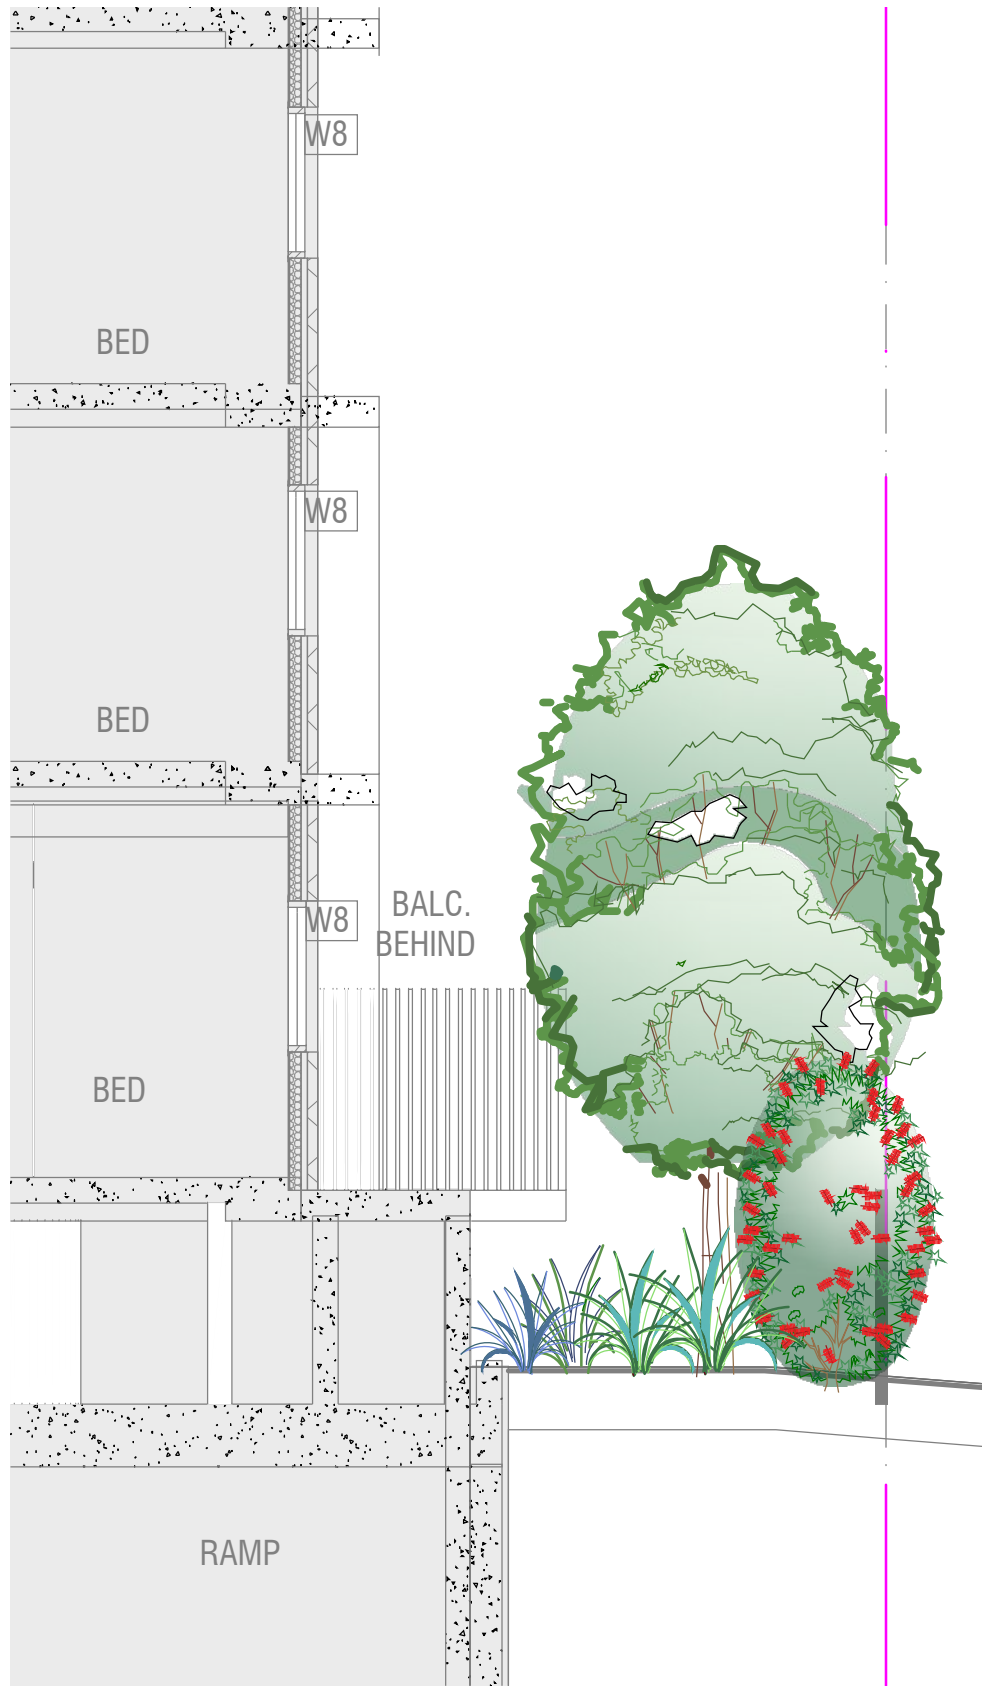

SECTION A-A
SCALE N.T.S

General Notes:
Figured dimensions take preference to scale readings. Verify all dimensions on site. PDF'd plans may vary slightly in Scale for that indicated on plans. Report any discrepancies to the Landscape Architect before proceeding with the work.
© Copyright Sulphurcrest Enterprises Pty Ltd Trading as CONCEPT
(ABN: 75 623 405 630)
This drawing is protected by copyright. All rights are reserved. Unless permitted under the Copyright Act 1968, no part of this drawing may in any form or by any means be reproduced, published, broadcast or transmitted without the prior written permission of the copyright owner.
If the Status of this drawing is not signed off For Construction it may be subject to change, alteration or amendment at the discretion of our office. It is, Concept is not liable for any loss, damage, harm or injury whether special, consequential, direct or indirect, suffered by you or any other person as a result of your use of this drawing for construction purposes.
These plans and associated IP remain the property of Sulphurcrest Enterprises (T/A Concept) until such time as all agreed payments are made in full. We retain the right to withdraw this information from the assessment process if such payments are not made following the notification period.



REV	DATE	NOTATION/AMENDMENT
A	21.10.2021	Drafted S4.55 plan prepared for review
B	02.11.2021	Issued for S4.55

COUNCIL	PARRAMATTA COUNCIL
CLIENT	ANTHILL CONSTRUCTION
ARCHITECT	GHAZI AL ALI
STATUS / ISSUE	S4.55 - ISSUE B



TITLE:	DETAILS
DWG.No:	LPS4.55 21 - 154 / 5
SCALE:	AS SHOWN @ A3
DATE:	NOV 2021
DRAWN:	K.Z
CHECKED:	R.F

LANDSCAPE WORK SPECIFICATION
Project:

PRELIMINARIES

1.01 GENERAL

The following general conditions should be considered prior to the commencement of landscape works:

- The landscape plans should be read in conjunction with the architectural plans, hydraulic plans, service plans and survey prepared for the proposed development.
- All services including existing drainage should be accurately located prior to the commencement of landscape installation. Any proposed tree planting which falls close to services will be relocated on site under the instruction of the landscape architect.
- Installation of conduit for required irrigation, electrical and other services shall be completed prior to the commencement of hardscape works and hardstand pours.
- All outdoor lighting specified by architect or client to be installed by qualified electrician
- Anomalies that occur in these plans should be brought to our immediate attention.
- Where an Australian Standard applies for any landscape material testing or installation technique, that standard shall be followed.

1.02 PROTECTION OF ADJACENT FINISHES

The Contractor shall take all precautions to prevent damage to all or any adjacent finishes by providing adequate protection to these areas / surfaces prior to the commencement of the Works

1.03 PROTECTION OF EXISTING TREES

Existing trees identified to be retained shall be done so in accordance with NATSPEC Guide 2 "A Guide to Assessing Tree Quality". Where general works are occurring around such trees, or pruning is required, a qualified Arborist shall be engaged to oversee such works and manage tree health.

Existing trees designated on the drawing for retention shall be protected at all times during the construction period. Any soil within the drip-line of existing trees shall be excavated and removed by hand only. No stockpiling shall occur within the root zone of existing trees to be retained. Any roots larger in diameter than 50mm shall only be severed under instruction by a qualified arborist. Roots smaller than 50mm diameter shall be cut cleanly with a saw. Temporary fencing shall be installed around the base of all trees to be retained prior to the commencement of landscape works. Where possible this fencing will be located around the drip line of these trees, or a minimum of 3m from the trunk. The fencing shall be maintained for the full construction period.

1.04 EROSION & POLLUTION CONTROL

The Contractor shall take all proper precautions to prevent the erosion of soil from the subject site. The contractor shall install erosion & sediment control barriers and as required by council, and maintain these barriers throughout the construction period. Note that the sediment control measures adopted should reflect the soil type and erosion characteristics of the site.

Erosion & pollution control measures shall incorporate the following:
- Construction of a sediment trap at the vehicle access point to the subject site.
- Sediment fencing using a geotextile filter fabric in the location indicated on the erosion control plan or as instructed on site by the landscape architect.
- Earth banks to prevent scour of stockpiles
- Sandbag kerb sediment traps
- Straw bale & geotextile sediment filter.
- Exposed banks shall be pegged with an approved Jute matting in preparation for mass planting

Refer to "Sitewise Reference Kit" as prepared by DLWC & WSROC (1997) for construction techniques

SOIL WORKS

2.01 MATERIALS

Specified Soil Conditioner (Generally to improve site soil)

The specified soil conditioner for site top-soil improvement shall be an organic mix, equal to "Botany Humus", as supplied by ANL. Note that for sites where soil testing indicates toxins or extremes in pH, or soils that are extremely poor, allow to excavate and supply 300mm of imported soil mix.

New gardens & proposed Planting

New garden and planting areas shall consist of a 50/50 mix of clean site soil (refer d) below) and imported "Organic Garden Mix" as supplied by ANL or approved equal. All mixes are to comply with AS 4419 Soils for landscaping & garden use, & AS 4454 Composts, Soil conditioners & mulches.

Specified Soil Mix - Turf

The specified soil mix for all turf areas shall be a min 75mm layer of imported soil mix consisting of 80% washed river sand (reasonably coarse), and 20% composted organic matter equivalent to mushroom compost or soil conditioner, or other approved lawn top dress.

Site Topsoil

Site topsoil is to be clean and free of unwanted matter such as gravel, clay lumps, grass, weeds, tree roots, sticks, rubbish and plastics, and any deleterious materials and materials toxic to plants. The topsoil must have a pH of between 5.5 and 7. Use 100% imported soil mix when site when site topsoil runs out.

2.02 INSTALLATION

a) Testing

All testing is to be conducted in accordance with AS 1289 Methods for testing soils for engineering purposes. Site soil shall be given a pH test prior to modifying to ensure conditions are appropriate for planting as stated above. Tests shall be taken in several areas where planting is proposed, and the pH shall be adjusted accordingly with sulphur or lime to suit.

Note that a soil test conducted by the "Sydney Soil Lab" or approved equal shall be prepared for all commercial, industrial and multi-unit residential sites. The successful landscape contractor shall implement the recommendations of this test.

b) Set Out of Individual Trees & Mass Planting Areas

All individual tree planting positions and areas designated for mass planting shall be set out with stakes or another form of marking, ready for inspection and approval. Locate all services.

c) Establishing Subgrade Levels

Subgrade levels are defined as the finished base levels prior to the placement of the specified material (i.e. soil conditioner). The following subgrade levels shall apply:

- Mass Planting Beds - 300mm below existing levels with specified imported soil mix.
- Turf areas - 100mm below finished surface level.

Note that all subgrades shall consist of a relatively free draining natural material, consisting of site topsoil placed previously by the Civil Contractor. No builders waste material shall be acceptable.

d) Subgrade Cultivation

Cultivate all subgrades to a minimum depth of 100mm in all planting beds and all turf areas, ensuring a thorough breakup of the subgrade into a reasonably coarse tilth. Grade subgrades to provide falls to surface and subsurface drains, prior to the placement of the final specified soil mix.

e) Drainage Works

Install surface and subsurface drainage where required and as detailed on the drawing. Drain subsurface drains to outlets provided, with a minimum fall of 1:100 to outlets and / or service pits.

f) Placement and Preparation of Specified Soil Conditioner & Mixes.

- Trees in turf & beds - Holes shall be twice as wide as root ball and minimum 100mm deeper - backfill hole with 50/50 mix of clean site soil and imported "Organic Garden Mix" as supplied by ANL or approved equal.
 - Mass Planting Beds - Install specified soil conditioner to a compacted depth of 100mm
- Place the specified soil conditioner to the required compacted depth and use a rotary hoe to thoroughly mix the conditioner into the top 300mm of garden bed soil. Ensure thorough mixing and the preparation of a reasonably fine tilth and good growing medium in preparation for planting.
- Turf Areas - Install specified soil mix to a minimum compacted depth of 75mm.

Place the specified soil mix to the required compacted depth and grade to required finished soil levels, in preparation for planting and turfing.

PLANTING

3.01 MATERIALS

a) Quality and Size of Plant Material

All trees supplied above a 25L container size must be grown and planted in accordance with *Clarke, R 1996 Purchasing Landscape Trees: A guide to assessing tree quality. Natspec Guide No. 2*. Certification that trees have been grown to Natspec guidelines is to be provided upon request of Council's Tree Management Officer.

Above - Ground Assessment:

The following plant quality assessment criteria should be followed:

Plant true to type, Good vigour and health, free from pest & disease, free from injury, self-supporting, good stem taper, has been pruned correctly, is apically dominant, has even crown symmetry, free from included bark & stem junctions, even trunk position in pot, good stem structure

Below - Ground Assessment:

Good root division & direction, rootball occupancy, rootball depth, height of crown, non-suckering For further explanation and description of these assessment criteria, refer to Ross Clark's book.

All Plant material shall be to the type and size specified. No substitutions of plant material shall be permitted without written prior approval by the Landscape Architect. No plant shall be accepted which does not conform to the standards listed above.

b) Stakes and Ties

Provide min. 3 No. Stakes and ties to all plants identified as trees in the plant schedule. Stakes shall be sound, unpainted, straight hardwood, free of knots and pointed at one end. They shall be 2200mm x 50mm x 50mm Hardwood, or approved alternative. Ties shall be 50mm wide hessian webbing material.

c) Fertilisers

Fertilisers shall be approved slow release fertilisers suitable for the proposed planting types. Note that for native plants, specifically Proteaceae family plants including Grevillea species, low phosphorus fertilizers shall be used.

d) Mulch

Mulch shall be an approved equal to "Forest Blend" as supplied by ANL. Mulch shall be completely free from any soil, weeds, rubbish or other debris.

e) Turf

Turf shall be "Sir Walter" Buffalo or equivalent (unless stated otherwise), free from any weeds and other grasses, and be in a healthy growing condition.

3.02 INSTALLATION

a) Setting Out

All planting set out shall be in strict accordance with the drawings, or as directed. Note that proposed tree planting located near services should be adjusted at this stage. Notify Landscape Architect for inspection for approval prior to planting.

b) Planting

All plant material shall be planted as soon after delivery as possible. Planting holes for trees shall be excavated as detailed and specified. Plant containers shall be removed and discarded, and the outer roots gently teased from the soil mass. Immediately set plant in hole and backfill with specified soil mix, incorporating the approved quantity of fertiliser for each plant type. Ensure that plants are set plumb vertically and root balls set to the consolidated finished grades detailed on the drawings. Compact the backfilled soil and saturate by hand watering to expel any remaining air pockets immediately after planting.

c) Staking and Tying

Staking and tying shall be in strict accordance with the drawings and shall occur immediately following plant placement and soil backfilling. All plants identified as "Trees" on the planting schedule shall be staked with a min. 3 stakes.

d) Mulching

Mulch should be spread so that a compacted thickness of 75mm is achieved after settlement in all planting beds and around each individual plant. Apply immediately following planting and watering in, ensuring that a 50mm radius is maintained around the trunk of each plant. There shall be no mixing of soil and mulch material.

e) Turfing

Moisten soil prior to the turf being laid. Turf shall be neatly butt jointed and true to grade to finish flush with adjacent surfaces. Incorporate a lawn fertilizer and thoroughly water in. Keep turf moist until roots have taken and sods/rolls cannot be lifted. Keep all traffic off turf until this has occurred. Allow for top dressing of all turf areas. All turf shall be rolled immediately following installation.

f) Steel edgingThe Contractor shall install steel edging as detailed on the drawings, to all mass planting beds adjoining turf or gravel mulched areas, and where required. The resultant edge shall be true to line and flush with adjacent surfaces.

g) Stepping Stones

400mm SQ stepping stones (or similar approved dimensions) shall be placed as indicated on plan at 300mm intervals. Finish and colour of stepping stones shall be nominated by the client. Install stepping stones as detail, flush with adjoining elements.

HARDSCAPE WORKS

4.01 GENERAL

The Contractor shall undertake the installation of all hardscape works as detailed on the drawing, or where not detailed, by manufacturers specification.

- Paving - refer to typical details provided, and applicable Australian Standards. *Permeable paving may be used as a suitable means of satisfying Council permeable surface requirements, while providing a useable, hardwearing, practical surface.* In most instances, the client shall nominate the appropriate paving material to be used.

Australian Standards shall be adhered to in relation to all concrete, masonry & metal work. Some details are typical and may vary on site. All hardscape works shall be setout as per the drawings, and inspected and approved by the Landscape Architect prior to installation. All workmanship shall be of the highest standard. Any queries or problems that arise from hardscape variations should be bought to the attention of the Landscape Architect.

Your attention is directed to any obligations or responsibilities under the Dividing Fences Act, 1991 in respect of adjoining property owner/s which may arise from this application. Any enquiries in this regard may be made to the Crown Lands Division on (02) 8836 5332.

IRRIGATION WORKS

5.01 GENERAL (PERFORMANCE SPECIFICATION)

New irrigation systems to planting areas shall be a Commercial Grade Irrigation System conforming to AS 3500 & the latest Sydney Water Code

The irrigation system shall be installed prior to all planting works. It shall incorporate a commercially available irrigation system, with dripper lines for all trees, and suitable jet sprinkler heads for the shrub species specified. It shall also incorporate a suitable back flow prevention device for the scale of works, an in-line filter, check valves, and suitable high and low density poly hose fittings and PVC piping to achieve flow rates suitable for specified planting.

The landscape contractor shall check the existing pressure available from the ring mains and size irrigation piping to suit. Supply shall be from local hose cock where available. All piping and fittings are to be buried 50mm below the finished soil levels in garden bed areas, and secured in position at 5m centre with galv wire pins. Sizing of pipes shall be done so as to ensure that the working pressure at the end of the line does not decrease by more than 5%.

Upon completion of installation, the system shall be tested and all components are to be satisfactorily functional and operational prior to approval. Should any defect develop, or the capacity or efficiency of the system decline during the agreed maintenance system, then these faults shall be immediately rectified.

Detailed drawings of the entire proposed irrigation system shall be made available to the client for records and future maintenance of the system.

CONSOLIDATION AND MAINTENANCE




6.01 GENERAL

The consolidation and maintenance period shall be 12 months beginning from the approved completion of the specified construction work (Practical Completion). A qualified landscape maintenance contractor shall undertake the required landscape maintenance works. Consolidation and maintenance shall mean the care and maintenance of Contracted works by accepted landscaping or horticultural practices, ensuring that all plants are in optimum growing conditions and appearance at all times, as well as rectifying any defects that become apparent in the contracted works.

This shall include, but not be limited to, the following items where and as required:

- Watering all planting and lawn areas / irrigation maintenance.
- Clearing litter and other debris from landscaped areas.
- Removing weeds, pruning and general plant maintenance.
- Replacement of damaged, stolen or unhealthy plants.
- Make good areas of soil subsidence or erosion.
- Topping up of mulched areas.
- Spray / treatment for Insect and disease control.
- Fertilizing with approved fertilizers at correct rates.
- Mowing lawns & trimming edges each 14 days in summer or 18 days in winter
- Adjusting ties to Stakes
- Maintenance of all paving, retaining and hardscape elements.

On the completion of the maintenance period, the landscape works shall be inspected and at the satisfaction of the superintendent or landscape architect, the responsibility will be signed over to the client.

General Notes: Figured dimensions take precedence to scale readings. Verify all dimensions on site. PDF'd plans may vary slightly in Scale for that indicated on plans. Report any discrepancies to the Landscape Architect before proceeding with the work. © Copyright Sulphurcrest Enterprises Pty Ltd Trading as CONZEPT (ABN: 75 623 405 630) <small>This drawing is protected by copyright. All rights are reserved. Unless permitted under the Copyright Act 1968, no part of this drawing may in any form or by any means be reproduced, published, broadcast or transmitted without the prior written permission of the copyright owner. If the Status of this drawing is not signed off For Construction it may be subject to change, alteration or amendment at the discretion of our office. If so, Concept is not liable for any loss, damage, harm or injury whether special, consequential, direct or indirect, suffered by you or any other person as a result of your use of this drawing for construction purposes. These plans and associated IP remain the property of Sulphurcrest Enterprises (T/A Concept) until such time as all agreed payments are made in full. We retain the right to withdraw this information from the assessment process if such payments are not made following the notification period.</small>	AILA Associate  		REV	DATE	NOTATION/AMENDMENT	COUNCIL	 www.conzept.net.au enquiries@conzept.net.au Phone: 9922 5312 Suite 101, 506 Miller St CAMMERAY NSW 2062	TITLE: SPECIFICATION PROPOSED RESIDENTIAL FLAT BUILDING DEVELOPMENT 125-129 ARTHUR STREET PARRAMATTA	DWG.No: LPS4.55 21 - 154 / 6	
			A	21.10.2021	Drafted S4.55 plan prepared for review	PARRAMATTA COUNCIL			SCALE: N/A	
			B	02.11.2021	Issued for S4.55	CLIENT ANTHILL CONSTRUCTION			DATE: NOV 2021	
						ARCHITECT GHAZI AL ALI			DRAWN: K.Z	
						STATUS / ISSUE S4.55 - ISSUE B			CHECKED: R.F	