




NDS	- HED WEIR RL 3 - OVERFLOW RL 30.50		
	A RL 29.48		
⁴⁸ PROVII VALVE	DE 1xØ150mmF AT BOTTOM	LAP	
	4 5 6 I I I	7 8	9 10
ORMWATER	STORMWATER MANAGEMENT – SCALE: N.T.S.	usd details -	1
SW I	DESIGN BY: DRAWN BY:	CHECK BY:	PAGE:
DRAWINGS, D THE OF G AND	R.H. I.R.	R.H.	6
AND ED OR THOUT JSSIE	JOB NUMBER: 190474		ISSUE: D

	~~~~~~~~~~~~~~~~~~~~~~~~~~~~~~~~~~~~~~~	~~~~~~	~~~~~~	~~~~~	~~~~~~	~~~~~~~~~~~~~~~~~~~~~~~~~~~~~~~~~~~~~~~	~~~~~	PARRAN	ATTA CITY	COUNCIL
								On-Site Deter	ntion Calculatio	n Sheet
							OSD	OSD	UPRCT	
							Site Area		0.0934	
}							Basic Stor Basic Disc	age Volume harae	43.90 7.47	
								2		
							Area of Si Percentage	te to Storage e of Site	<b>0.0861</b> 92.18	
Ι ζ							Storage pe	er ha of contributing are	a 509.85	
}							Volume/PS PSD for si	5D Adjustment te	71.65 6.17	
							Maximum I	Head to Orifice Centre	0.890	
}							Calculated Maximum (	Orifice Diameter discharge	<b>0.055</b> 6.166	
								nigh early discharge	0.790	
}							High Early Mean Disc	_	5.809 5.988	
								narge ischarge per Hectare	5.988 69.545	
}							Final Site	Stance Datia	524	
$\langle \rangle$							Site Store	Storage Ratio Ige Volume	<b>45.12</b>	
<u> </u>										
	GAP UNDER TO ALLOW ROVERLAND FLOW PATH SWALE SWALE TWL CANADA SWALE	900x900 OPENIN			D LIDS TO BE HINGED TYPE DPROOF "J-TYPE" LOCKS		SOIL GROUND OSD DETAI TWL 30.5 AREA=63.95 AV. DEPTH=0,72 E PROVIDED=47.96 <u>RL 29.7</u> DECTION I.T.5. 4x STORMFILTER	A 460mm HIGH	30.70 900x 30.52 wSUD	VALVE VALVE VALVE VALVE CROCK
PLOT	N COLOUR FOR CLARITY									
NOTE:	ALL LEVELS AND DETAILS NOTED BE CONFIRMED AND PROVIDED	) AS T.B.C. TO AUSSIE				~~~~~~~~~~~~~~~~~~~~~~~~~~~~~~~~~~~~~~~	~~~~~		~~~~~~~~~~~~~~~~~~~~~~~~~~~~~~~~~~~~~~~	
	TURAL ENGINEERS PRIOR TO CO			<u> </u>				ARCHITECT		
D	<u> </u>	.08.21			A A	AUSSIE STR			22 EDGEWORTH DAVID AVENUE	PROPOSED STORMWA No 21 BELLEVUE STREET NORTH PARRAMATTA, NSW
В	<u> </u>	.11.20			ASEN	ENGINEERS				<u>COPYRIGHT.</u> ALL RIGHTS RESERVED. THESE DRAWINGS,
Δ	<u> </u>	.04.20			ALISTIE STRUCTURAL ENCINEERS Alistatisti Hill 175	ABN 96 619 6 Mobile: 0416	747 645			PLANS AND SPECIFICATIONS AND THE COPYRIGHT ARE THE PROPERTY OF AUSSIE STRUCTURAL ENGINEERS AND
ISSUE			DESCRIPTION	DATE		Email: design@aus 35 COBHAM STREET, KING	sieseng.com 5 PARK NSW 2	148.		MUST NOT BE USED, REPRODUCED OR COPIED WHOLLY OR IN PART WITHOUT THE WRITTEN PERMISSION OF AUSSIE STRUCTURAL ENGINEERS.
				I II		J		II		STAUGTURAL ENGINEERS.

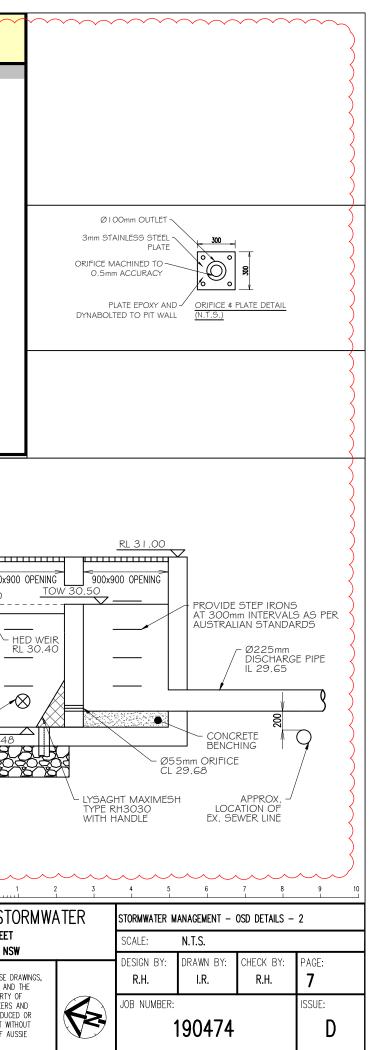

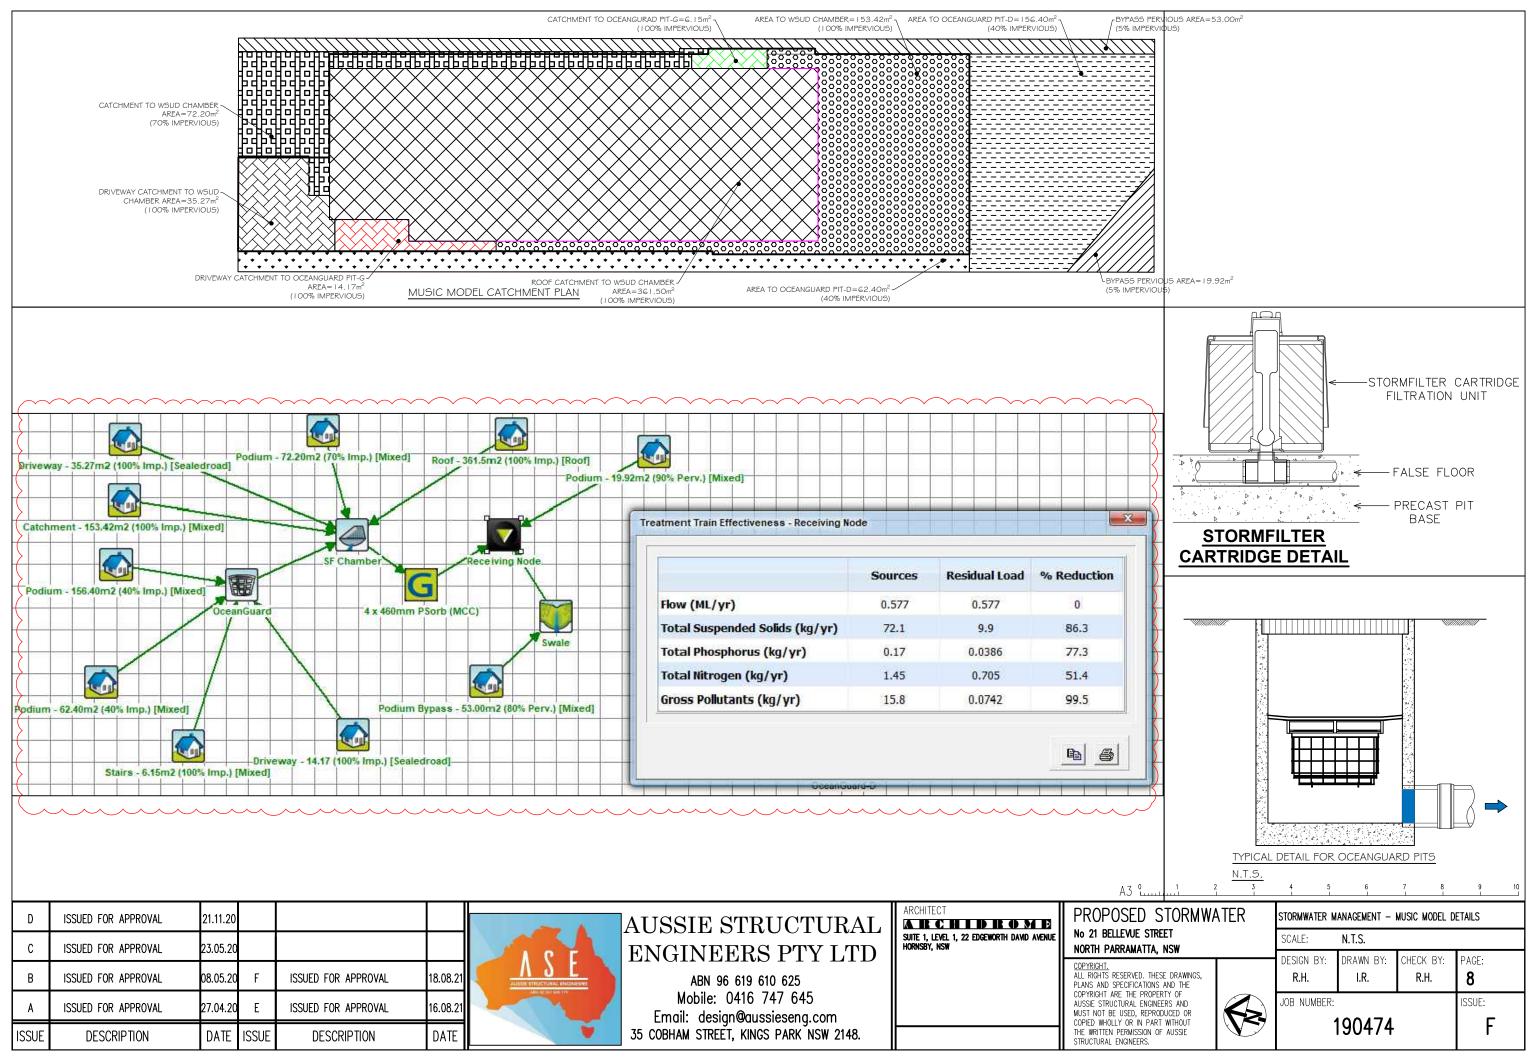

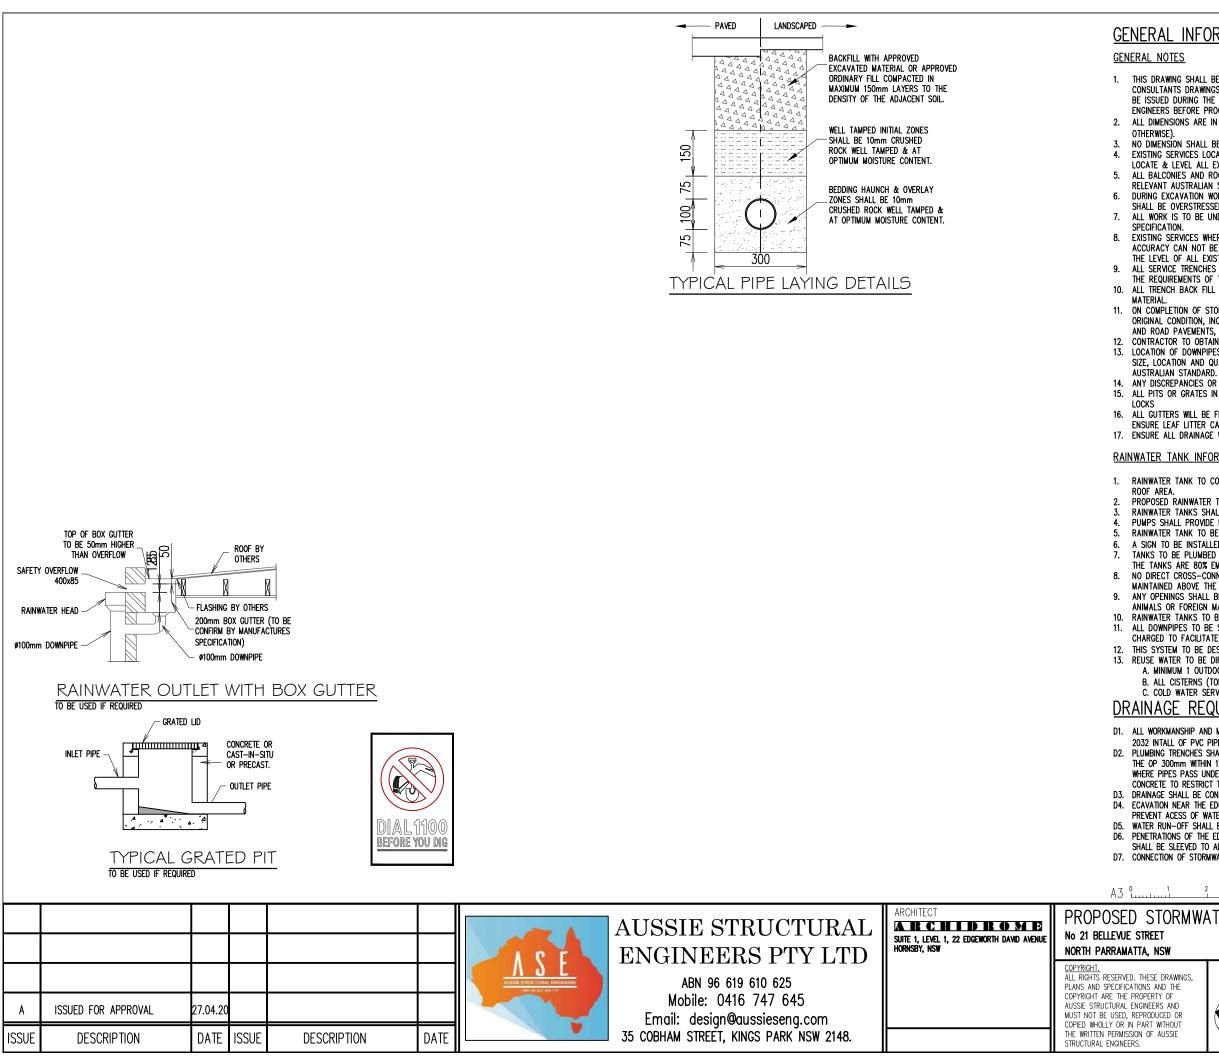

## GENERAL INFORMATION

THIS DRAWING SHALL BE READ IN CONJUNCTION WITH ARCHITECTURAL, LANDSCAPE AND OTHER CONSULTANTS DRAWINGS AND SPECIFICATIONS AND WITH OTHER SUCH WRITTEN INSTRUCTION AS MAY BE ISSUED DURING THE COURSE OF THE CONTRACT. ANY DISCREPANCY SHALL BE REFERRED TO THE ENGINEERS BEFORE PROCEEDING WITH THE WORK.

2. ALL DIMENSIONS ARE IN MILLIMETERS & ALL LEVELS ARE IN METERS, UNO (UNLESS NOTED

NO DIMENSION SHALL BE OBTAINED BY SCALING THE DRAWINGS.

EXISTING SERVICES LOCATIONS SHOWN INDICATIVE ONLY. IT IS THE CONTRACTORS RESPONSIBILITY TO LOCATE & LEVEL ALL EXISTING SERVICES PRIOR TO COMMENCEMENT OF ANY WORKS. ALL BALCONIES AND ROOFS TO BE DRAINED AND TO HAVE SAFETY OVERFLOWS IN ACCORDANCE WITH

RELEVANT AUSTRALIAN STANDARDS. ALL EXTERNAL SLABS TO BE WATERPROOFED. DURING EXCAVATION WORK, THE STRUCTURE SHALL BE MAINTAINED IN A STABLE AND NO PART

SHALL BE OVERSTRESSED. ALL WORK IS TO BE UNDERTAKEN IN ACCORDANCE WITH THE DETAILS SHOWN ON THE DRAWINGS &

EXISTING SERVICES WHERE SHOWN HAVE BEEN PLOTTED FROM SUPPLIED DATA AND SUCH THEIR

ACCURACY CAN NOT BE GUARANTEED. IT IS THE RESPONSIBILITY OF THE CONTRACTOR TO ESTABLISH THE LEVEL OF ALL EXISTING SERVICE PRIOR TO THE COMMENCEMENT OF WORK.

ALL SERVICE TRENCHES UNDER VEHICULAR PAVEMENTS SHALL BE BACK FILLED IN ACCORDANCE WITH THE REQUIREMENTS OF THE LOCAL COUNCIL 10. ALL TRENCH BACK FILL MATERIAL SHALL BE COMPACTED TO THE SAME DENSITY AS THE ADJACENT

11. ON COMPLETION OF STORNWATER INSTALLATION, ALL DISTURBED AREAS MUST BE RESTORED TO ORIGINAL CONDITION, INCLUDING KERBS, FOOTPATHS, CONCRETE AREAS, GRAVEL AND GRASSED AREAS AND ROAD PAVEMENTS, UNLESS DIRECTED OTHERWISE.

CONTRACTOR TO OBTAIN ALL AUTHORITY APPROVALS UNLESS DIRECTED OTHERWISE. LOCATION OF DOWNPIPES AND FLOOR WASTES ARE INDICATIVE ONLY. DOWN PIPE AND FLOOR WASTE SIZE, LOCATION AND QUANTITY TO BE DETERMINED BY BUILDER & IN ACCORDANCE WITH RELEVANT

14. ANY DISCREPANCIES OR OMISSIONS SHALL BE REFEREED TO THE DESIGN ENGINEER FOR RESOLUTION. 15. ALL PITS OR GRATES IN TRAFFICABLE ARES TO BE HEAVY DUTY. ALL GRATES TO HAVE CHILD PROOF

16. ALL GUTTERS WILL BE FITTED WITH LEAF GUARDS AND SHOULD BE INSPECTED AND CLEANED TO ENSURE LEAF LITTER CANNOT ENTER THE DOWNPIPES. 17. ENSURE ALL DRAINAGE WORKS ARE AWAY FROM TREE ROOTS.

## RAINWATER TANK INFORMATION

RAINWATER TANK TO COLLECT RAIN RUNOFF FROM AT LEAST AS PER BASIX SQUARE METERS OF

PROPOSED RAINWATER TANK SIZE AS PER SUPPLIERS SPECIFICATIONS

RAINWATER TANKS SHALL BE CONNECTED TO MAINS WATER SUPPLY AS BACKUP

PUMPS SHALL PROVIDE MINIMUM 150kPg PRESSURE. RAINWATER TANK TO BE CONNECTED AS PER BASIX REQUIREMENTS.

A SIGN TO BE INSTALLED STATING "NOT FOR HUMAN CONSUMPTION".

TANKS TO BE PLUMBED TO TOP-UP FROM THE POTABLE WATER SUPPLY DURING DRY PERIODS WHEN THE TANKS ARE 80% EMPTY.

NO DIRECT CROSS-CONNECTION WITH THE SYDNEY WATER POTABLE SUPPLY AND AN AIR GAP MAINTAINED ABOVE THE OVERFLOW IN THE TANK.

ANY OPENINGS SHALL BE MESHED OR SEALED TO PREVENT MOSQUITOS BREEDING AND ENTRY OF ANIMALS OR FOREIGN MATTER.

10. RAINWATER TANKS TO BE CLEANED OUT EVERY 6 MONTHS. 11. ALL DOWNPIPES TO BE SEALED TO UNDERSIDE OF FIRST FLOOR GUTTER AS DRAINAGE SYSTEM IS CHARGED TO FACILITATE PROPOSED ABOVE GROUND REUSE TANK.

12. THIS SYSTEM TO BE DESIGNED WITH A 'FIRST FLUSH' DIVERSION TO REMOVE ROOF CONTAMINANTS. 13. REUSE WATER TO BE DIRECTED TO THE FOLLOWING: A. MINIMUM 1 OUTDOOR GARDEN TAP

B. ALL CISTERNS (TOILETS) C. COLD WATER SERVICE TO THE CLOTHES WASHER.

## DRAINAGE REQUIREMENTS

D1. ALL WORKMANSHIP AND MATERIAL SHALL BE IN ACCORDANCE WITH CURRENT EDITIONS OF AS2870, AS/NZS 2032 INTALL OF PVC PIPES AND AS/NZS 3500 PLUMBING & DRAINAGE.

D2. PLUMBING TRENCHES SHALL BE SLOPED AWAY FROM THE HOUSE AND SHALL BE BACKFILLED WITH CLAY IN THE OP 300mm WITHIN 1.5m OF THE HOUSE. THE CLAY USED FOR BACKFILLING SHALL BE COMPACTED. WHERE PIPES PASS UNDER THE FOOTING SYSTEM. THE TRENCH SHALL BE BACKFILLED WITH CLAY OR CONCRETE TO RESTRICT THE INGRESS OF WATER BENEATH THE FOOTING SYSTEM.


DRAINAGE SHALL BE CONSTRUCTED TO AVOID WATER PONDING AGAINST OR NEAR THE FOOTING.

ECAVATION NEAR THE EDGE OF THE FOOTING SYSTEM SHALL BE BACKFILLED IN SUCH A WAY AS TO PREVENT ACESS OF WATER TO THE FOUNDATION.

D5. WATER RUN-OFF SHALL BE COLLECTED AND CHANNELLED AWAY FROM THE HOUSE DURING CONSTRUCTION. D6. PENETRATIONS OF THE EDGE BEMS AND FOOTING BEAMS ARE TO BE AVOIDED, BUT WHERE NECESSARY SHALL BE SLEEVED TO ALLOW FOR MOVEMENT.

D7. CONNECTION OF STORWWATER DRAINS AND WASTE DRAINS SHALL BE INCLUDED FLEXIBLE CONNECTIONS.

1 Z	J	4 5	0	/ 8	9 10
ORMWA	TER	STORMWATER M	IANAGEMENT -	sections and	details sheet 1
w		SCALE:	N.T.S. U.N.O.		
RAWINGS, • THE		DESIGN BY: <b>R.H.</b>	drawn by: <b>I.R.</b>	CHECK BY: <b>R.H.</b>	PAGE: <b>9</b>
of AND ED OR HOUT SSIE		JOB NUMBER:	90474		ISSUE: <b>A</b>

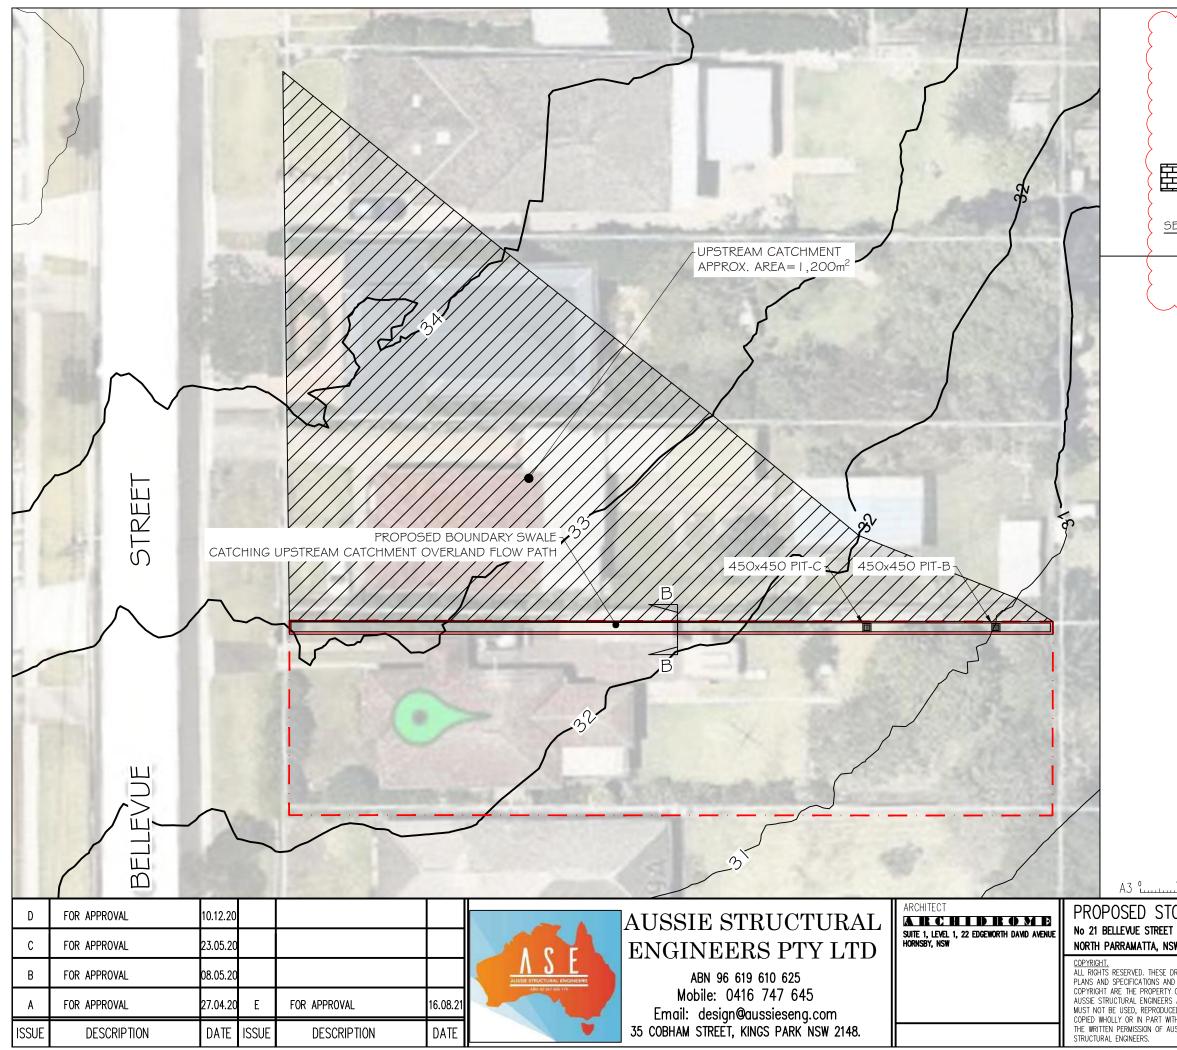

T SCALE: N.T.S.		NS LANDSCAPED SWALE	7 8	9 10
SW DESIGN BY: DRAWN BY: CHECK BY: PAGE:   DRAWINGS, ID THE ( OF S AND CFD OR R.H. I.R. R.H. 10	Т			
DRAWINGS, ID THE ( OF S AND CPL OR ID NUMBER: ISSUE: ISSUE: IS	SW		CHECK BY	PAGE
( OF S AND OF D OR JOB NUMBER: ISSUE:	DRAWINGS,			
	ND THE			
	CED OR	190474		E

